

99002

FOR OFFICE USE ONLY **194488**
 QUAD. NO. _____ SERIAL NO. _____
 Lat. _____ Long. _____ Pc _____
 Minor Basin _____
 Basin Code _____
 Header Ent. _____ GW-1 Ent. _____

WELL CONSTRUCTION RECORD

DRILLING CONTRACTOR: Dewey Wright Well & Pump Co. Inc.

STATE WELL CONSTRUCTION

DRILLER REGISTRATION NUMBER: 266 PERMIT NUMBER: Si. Reece

1. WELL LOCATION: (Show sketch of the location below)

Nearest Town: Afframont County: AVERY

OFF OLD 3 MILE ROAD

(Road, Community, or Subdivision and Lot No.)

2.	DEPTH		DRILLING LOG
	From	To	Formation Description
	0	89	DIRT
	89	355	GRANITE
	355	358	QUARTZ
	358	380	GRANITE

3. DATE DRILLED 01/11/99 USE OF WELL PVT

4. TOTAL DEPTH 380'

5. CUTTINGS COLLECTED YES NO

6. DOES WELL REPLACE EXISTING WELL? YES NO

7. STATIC WATER LEVEL Below Top of Casing: 20 FT.
 (Use "+" if Above Top of Casing)

8. TOP OF CASING IS 1 FT. Above Land Surface*

* Casing Terminated at/or below land surface is illegal unless a variance is issued in accordance with 15A NCAC 2C .0118

9. YIELD (gpm): 3 METHOD OF TEST AIR

10. WATER ZONES (depth): 3 gpm 355-358'


11. CHLORINATION: Type HTH Amount 72 tabs

12. CASING:

99 FEB 25 PM 12:54
 ENVIRONMENTAL SECTION

LOCATION SKETCH

(Show direction and distance from at least two State Roads, or other map reference points)

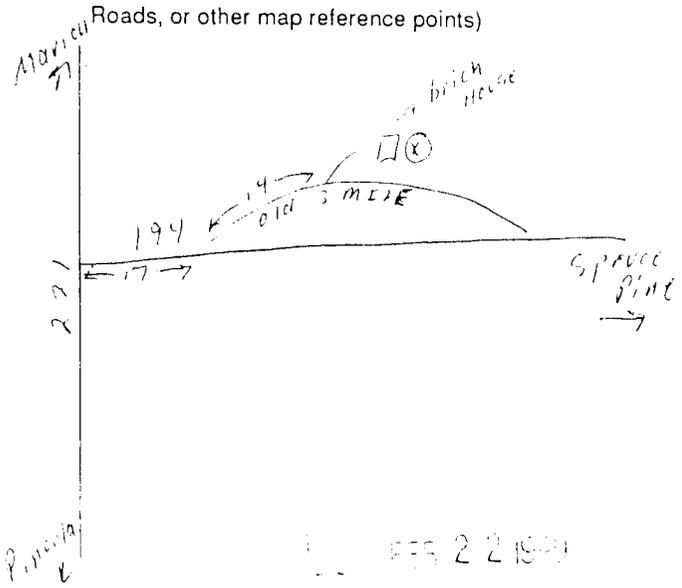

13. GROUT:

From	To	Depth	Material	Method
0	20	Ft.	CEMENT	PUMPED


14. SCREEN:

From	To	Depth	Diameter	Slot Size	Material
_____	_____	_____ Ft.	_____ in.	_____ in.	_____
_____	_____	_____ Ft.	_____ in.	_____ in.	_____
_____	_____	_____ Ft.	_____ in.	_____ in.	_____

15. SAND/GRAVEL PACK:

From	To	Depth	Size	Material
_____	_____	_____ Ft.	_____	_____
_____	_____	_____ Ft.	_____	_____

16. REMARKS:

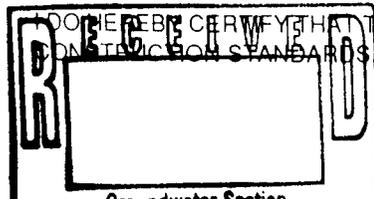

Barbara M. Caden 2/17/99
 SIGNATURE OF CONTRACTOR OR AGENT DATE