

99057

FOR OFFICE USE ONLY
 QUAD NO. SERIAL NO. **197256**
 Lat. Long. Pc.
 Minor Basin
 Basin Code
 Header Ent. **GW-1 Ent**

WELL CONSTRUCTION RECORD

DRILLING CONTRACTOR: Dewey Wright Well & Pump Co. Inc. STATE WELL CONSTRUCTION
 DRILLER REGISTRATION NUMBER: 266 PERMIT NUMBER: S. Petty

1. WELL LOCATION: (Show sketch of the location below)
 Nearest Town: Banner Elk County: AVERY
OFF PHILLIPS RD. OFF BUCKEYE RD #1309
 (Road, Community, or Subdivision and Lot No.)


2.
 3. DATE DRILLED 03/31/99 USE OF WELL PVT
 4. TOTAL DEPTH 205'
 5. CUTTINGS COLLECTED YES NO
 6. DOES WELL REPLACE EXISTING WELL? YES NO
 7. STATIC WATER LEVEL Below Top of Casing: 40 FT.
 (Use "+" if Above Top of Casing)
 8. TOP OF CASING IS 1 FT. Above Land Surface*
 * Casing Terminated at/or below land surface is illegal unless a variance is issued
 in accordance with 15A NCAC 2C .0118
 9. YIELD (gpm): 10 METHOD OF TEST AIR
 10. WATER ZONES (depth): 1 gpm 41-42' 9 gpm 180-182'

DEPTH		DRILLING LOG
From	To	Formation Description
0	12	DIRT
12	41	GRANITE
41	42	SHALE
42	180	GRANITE
180	182	SHALE
182	205	GRANITE

99 MAY - 5 MILLI: 25

11. CHLORINATION: Type HTH Amount 35 tabs If additional space is needed use back of form
 12. CASING:

LOCATION SKETCH

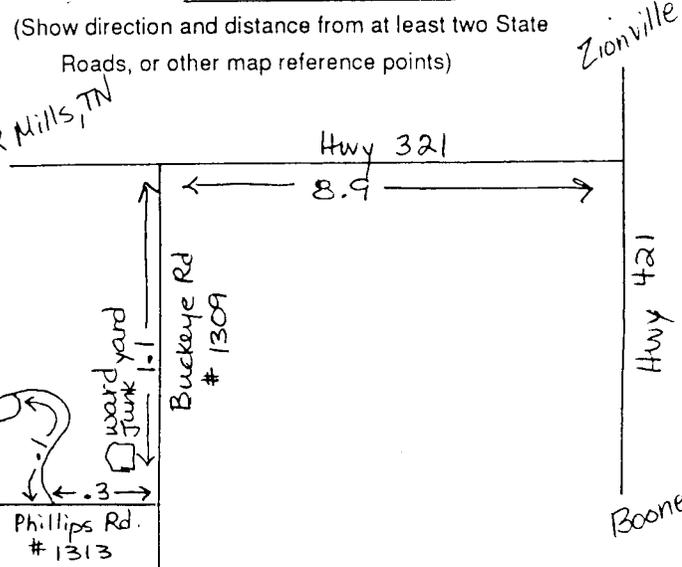

Depth	Diameter	Wall Thickness or Weight/Ft.	Material
From <u>0</u> To <u>21</u> Ft.	<u>6 1/4</u>	<u>0.188</u>	<u>GALV</u>

13. GROUT:

Depth	Material	Method
From <u>0</u> To <u>20</u> Ft.	<u>CEMENT</u>	<u>PUMPED</u>

14. SCREEN:

Depth	Diameter	Slot Size	Material
From <u> </u> To <u> </u> Ft.	<u> </u> in.	<u> </u> in.	<u> </u>

15. SAND/GRAVEL PACK:

Depth	Size	Material
From <u> </u> To <u> </u> Ft.	<u> </u>	<u> </u>

16. REMARKS:

I DO HEREBY CERTIFY THAT THIS WELL WAS CONSTRUCTED IN ACCORDANCE WITH 15A NCAC 2C, WELL CONSTRUCTION STANDARDS, AND THAT A COPY OF THIS RECORD HAS BEEN PROVIDED TO THE WELL OWNER.

RECEIVED
 MAY - 3 1999
 Groundwater Section
 Raleigh, NC

Janette Boisvert
 SIGNATURE OF CONTRACTOR OR AGENT

4-22-99
 DATE