

FOR OFFICE USE ONLY  
 QUA. NO. \_\_\_\_\_ SERIAL NO. 199130  
 Lat \_\_\_\_\_ Long \_\_\_\_\_ RO \_\_\_\_\_  
 Minor Basin \_\_\_\_\_  
 Basin Code \_\_\_\_\_  
 Header Ent. \_\_\_\_\_ GW-Ent \_\_\_\_\_

WELL CONSTRUCTION RECORD

DRILLING CONTRACTOR: BRASWELL Well Drilling

DRILLER REGISTRATION NUMBER: 163

STATE WELL CONSTRUCTION PERMIT NUMBER: \_\_\_\_\_

1. WELL LOCATION: (Show sketch of the location below)

Nearest Town: Linville Falls County: Avery

Davenport Rd.  
 (Road, Community, or Subdivision and Lot No.)

DEPTH

From To

DRILLING LOG

Formation Description

From	To	Formation Description
0	23	dirt
23	560	Blue Rock

2.

3. DATE DRILLED 5-20-99 USE OF WELL Residential

4. TOTAL DEPTH 560

5. CUTTINGS COLLECTED YES  NO

6. DOES WELL REPLACE EXISTING WELL? YES  NO


7. STATIC WATER LEVEL Below Top of Casing: \_\_\_\_\_ FT.  
 (Use "-" if Above Top of Casing)

8. TOP OF CASING IS 1 FT. Above Land Surface\*

\* Casing Terminated at/or below land surface is illegal unless a variance is issued in accordance with 15A NCAC 2C .0118

9. YIELD (gpm): 60 METHOD OF TEST Blown

10. WATER ZONES (depth): 240, 520 ft.

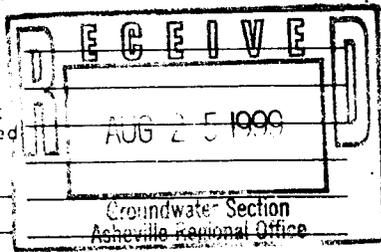

90 JUN 21 PM 2:35

11. CHLORINATION: Type chlorine Amount 3 tabs

12. CASING:

If additional space is needed use back of form

LOCATION SKETCH

(Show direction and distance from at least two State Roads, or other map reference points)

From	Depth	To	Diameter	Wall Thickness or Weight/Ft.	Material
0	0	28	6 3/4	sch. 80	PVC
From	To	Ft.			
From	To	Ft.			

13. GROUT:

From	Depth	To	Material	Method
0	0	20	cement	packed
From	To	Ft.		

14. SCREEN:


From	Depth	To	Diameter	Slot Size	Material
From	To	Ft.	in.	in.	
From	To	Ft.	in.	in.	
From	To	Ft.	in.	in.	

15. SAND/GRAVEL PACK:

From	Depth	To	Size	Material
From	To	Ft.		
From	To	Ft.		

16. REMARKS:

I DO HEREBY CERTIFY THAT THIS WELL WAS CONSTRUCTED IN ACCORDANCE WITH 15A NCAC 2C, WELL CONSTRUCTION STANDARDS, AND THAT A COPY OF THIS RECORD HAS BEEN PROVIDED TO THE WELL OWNER.

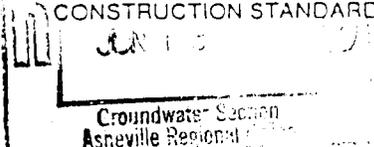

Kevin Roberts

SIGNATURE OF CONTRACTOR OR AGENT

5-20-99

DATE