

FOR OFFICE USE ONLY
 QUAD. NO. _____ SERIAL NO. 199132
 Lat _____ Long _____ RO _____
 Minor Basin _____
 Basin Code _____
 Header Ent. _____ GW-1 Ent. _____

WELL CONSTRUCTION RECORD

RILLING CONTRACTOR: BRASWELL Well Drilling

RILLER REGISTRATION NUMBER: 163

STATE WELL CONSTRUCTION PERMIT NUMBER: _____

WELL LOCATION: (Show sketch of the location below)

Nearest Town: Linville County: Avery

Grandmother Mtn. Lot 10
 (Road, Community, or Subdivision and Lot No.)

DEPTH

From To

0 - 10
10 - 200

DRILLING LOG

Formation Description

dirt
sandstone

DATE DRILLED 5-18-99 USE OF WELL Residential

TOTAL DEPTH 200

CUTTINGS COLLECTED YES NO

DOES WELL REPLACE EXISTING WELL? YES NO

STATIC WATER LEVEL Below Top of Casing: _____ FT.


(Use "-" if Above Top of Casing)

TOP OF CASING IS 1 FT. Above Land Surface*

Casing Terminated at/or below land surface is illegal unless a variance is issued in accordance with 15A NCAC 2C .0118

YIELD (gpm): 40 METHOD OF TEST Blow

3. WATER ZONES (depth): 80, 110, 130 yd

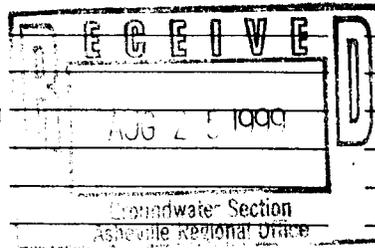

98 JUN 14 11 2: 85

If additional space is needed use back of form

1. CHLORINATION: Type chlorine Amount 3 tabs
 2. CASING:

From	Depth	To	Diameter	Wall Thickness or Weight/Ft.	Material
<u>0</u>	<u>21</u>	<u>Ft.</u>	<u>6 5/8</u>	<u>188</u>	<u>galv.</u>
From _____	To _____	Ft. _____	_____	_____	_____
From _____	To _____	Ft. _____	_____	_____	_____

LOCATION SKETCH

(Show direction and distance from at least two State Roads, or other map reference points)

3. GROUT:

From	Depth	To	Material	Method
<u>0</u>	<u>20</u>	<u>Ft.</u>	<u>cement</u>	<u>poured</u>
From _____	To _____	Ft. _____	_____	_____

4. SCREEN:


From	Depth	To	Diameter	Slot Size	Material
From _____	To _____	Ft. _____	_____ in.	_____ in.	_____
From _____	To _____	Ft. _____	_____ in.	_____ in.	_____
From _____	To _____	Ft. _____	_____ in.	_____ in.	_____

5. SAND/GRAVEL PACK:

From	Depth	To	Size	Material
From _____	To _____	Ft. _____	_____	_____
From _____	To _____	Ft. _____	_____	_____

6. REMARKS: _____

I DO HEREBY CERTIFY THAT THIS WELL WAS CONSTRUCTED IN ACCORDANCE WITH 15A NCAC 2C, WELL CONSTRUCTION STANDARDS, AND THAT A COPY OF THIS RECORD HAS BEEN PROVIDED TO THE WELL OWNER.

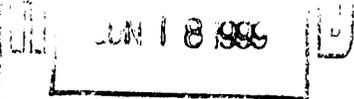

Kevin Peters
 SIGNATURE OF CONTRACTOR OR AGENT

5-18-99
 DATE