

99150

FOR OFFICE USE ONLY
 QUAD. NO. _____ SERIAL NO. 00269
 Lat _____ Long _____ Pc _____
 Minor Basin _____
 Basin Code _____
 Header Ent. _____ GW-1 Ent.

WELL CONSTRUCTION RECORD

DRILLING CONTRACTOR: Dewey Wright Well & Pump Co. Inc.

STATE WELL CONSTRUCTION

DRILLER REGISTRATION NUMBER: 266

PERMIT NUMBER: S. Petty

1. WELL LOCATION: (Show sketch of the location below)

Nearest Town: Banner Fork County: AVERY

OFF BEECH MTN. ROAD

(Road, Community, or Subdivision and Lot No.)

2.

DEPTH DRILLING LOG
 From To Formation Description

From	To	Formation Description
0	24	DIRT
24	230	GRANITE
230	231	SHALE
231	490	GRANITE
490	491	GRANITE
491	492	SHALE
492	505	GRANITE

RECEIVED/DEAR
 DWD GROUNDWATER SECTION
 99 JUL 16 PM 1:25

3. DATE DRILLED 04/27/99 USE OF WELL PVT
 4. TOTAL DEPTH 505'
 5. CUTTINGS COLLECTED YES NO
 6. DOES WELL REPLACE EXISTING WELL? YES NO
 7. STATIC WATER LEVEL Below Top of Casing: 360 FT.
 (Use "+" if Above Top of Casing)

8. TOP OF CASING IS 1 FT. Above Land Surface*

* Casing Terminated at/or below land surface is illegal unless a variance is issued in accordance with 15A NCAC 2C .0118

9. YIELD (gpm): 1/4 METHOD OF TEST AIR

10. WATER ZONES (depth): 1/4 gpm 491-492'

11. CHLORINATION: Type HTH Amount 30 tabs

If additional space is needed use back of form

12. CASING:

From	To	Depth	Diameter	Wall Thickness or Weight/Ft.	Material
From	To	Ft.			
From	To	0 To 28	6 1/4	0.188	GALV
From	To	Ft.			

13. GROUT:

From	To	Depth	Material	Method
From	To	Ft.		
From	To	0 To 20	CEMENT	PUMPED
From	To	Ft.		

14. SCREEN:

From	To	Depth	Diameter	Slot Size	Material
From	To	Ft.			
From	To	Ft.			
From	To	Ft.			




15. SAND/GRAVEL PACK:

From	To	Depth	Size	Material
From	To	Ft.		
From	To	Ft.		

16. REMARKS:

LOCATION SKETCH

(Show direction and distance from at least two State Roads, or other map reference points)

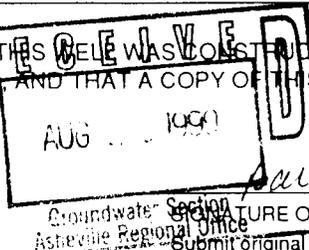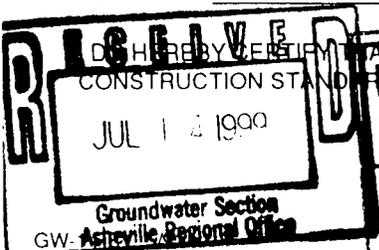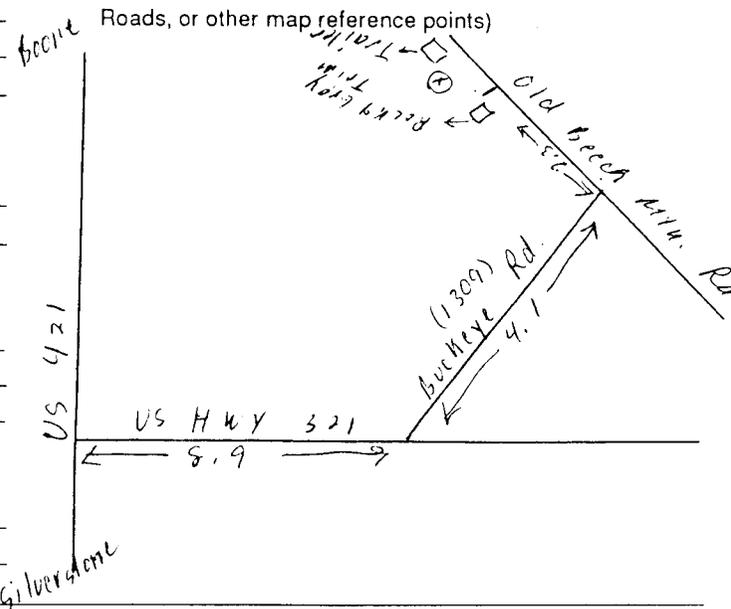

Barbara K. Caden

6/28/99