

99163

FOR OFFICE USE ONLY
 QUAD. NO. SERIAL NO. **200270**
 Lat. Long. Pc
 Minor Basin
 Basin Code
 Header Ent. GW-1 Ent

WELL CONSTRUCTION RECORD

DRILLING CONTRACTOR: Dewey Wright Well & Pump Co. Inc

DRILLER REGISTRATION NUMBER: 266 STATE WELL CONSTRUCTION PERMIT NUMBER: S. Reece

1. WELL LOCATION: (Show sketch of the location below)
 Nearest Town: Newland County: AVERY

TUCKER HOLLOW OFF OLD 19E
 (Road, Community, or Subdivision and Lot No.)

DEPTH	DEPTH		DRILLING LOG
	From	To	
	0	80	DIRT
	80	90	GRANITE
	90	93	SHALE
	93	125	GRANITE, QUARTZ

RECEIVED / DEPT. ENVIRONMENTAL & GROUNDWATER SECTION
99 JUL 16 PM 1:25

2. ur Rd.
3. DATE DRILLED 04/21/99 USE OF WELL PVT
4. TOTAL DEPTH 125'
5. CUTTINGS COLLECTED YES NO
6. DOES WELL REPLACE EXISTING WELL? YES NO
7. STATIC WATER LEVEL Below Top of Casing: 20 FT.
 (Use "+" if Above Top of Casing)
8. TOP OF CASING IS 1 FT. Above Land Surface*
- * Casing Terminated at/or below land surface is illegal unless a variance is issued in accordance with 15A NCAC 2C .0118
9. YIELD (gpm): 10 METHOD OF TEST AIR
10. WATER ZONES (depth): 10 gpm 90-93'

11. CHLORINATION: Type HTH Amount 22 tabs If additional space is needed use back of form

12. CASING:

Depth	Diameter	Wall Thickness or Weight/Ft.	Material
From <u>0</u> To <u>84</u> Ft.	<u>6 1/4</u>	<u>0.188</u>	<u>GALV</u>

13. GROUT:

Depth	Material	Method
From <u>2</u> To <u>20</u> Ft.	<u>CEMENT</u>	<u>PUMPED</u>


14. SCREEN:

Depth	Diameter	Slot Size	Material
From <u> </u> To <u> </u> Ft.	<u> </u> in.	<u> </u> in.	<u> </u>

15. SAND/GRAVEL PACK:

Depth	Size	Material
From <u> </u> To <u> </u> Ft.	<u> </u>	<u> </u>

16. REMARKS:

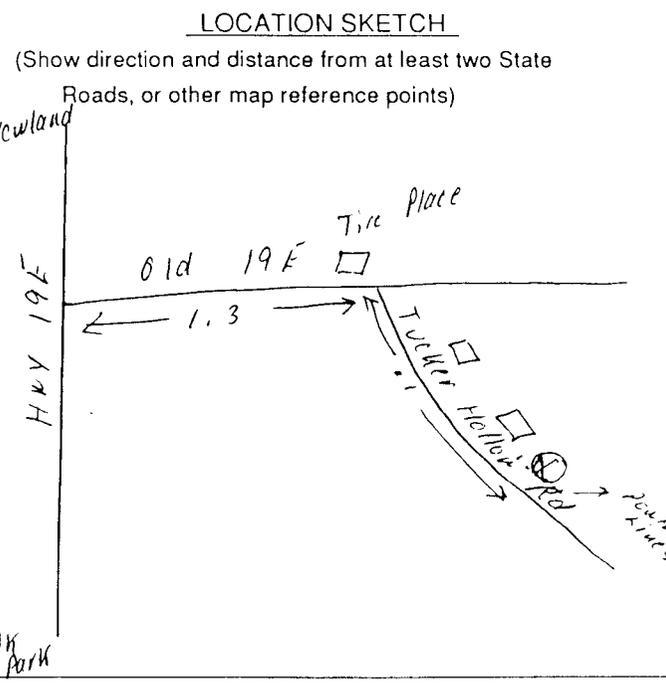

DO HEREBY CERTIFY THAT THIS WELL WAS CONSTRUCTED IN ACCORDANCE WITH 15A NCAC 2C, WELL CONSTRUCTION STANDARDS AND THAT A COPY OF THIS RECORD HAS BEEN PROVIDED TO THE WELL OWNER.

RECEIVED JUL 16 1999
RECEIVED AUG 10 1999

Signature of Contractor or Agent: Baukara K. Oden DATE: 6/26/99

Groundwater Section Asheville Regional Office
 Groundwater Section Asheville Regional Office
 Submit original to Division of Environmental Management and copy to well owner.