

98687

FOR OFFICE USE ONLY
 QUAD. NO. _____ SERIAL NO. 200862
 Lat. _____ Long. _____ Pc _____
 Minor Basin _____
 Basin Code _____
 Header Ent. _____ GW-1 Ent. _____

ARO

WELL CONSTRUCTION RECORD

DRILLING CONTRACTOR: Dewey Wright Well & Pump Co. Inc. STATE WELL CONSTRUCTION
 DRILLER REGISTRATION NUMBER: 266 PERMIT NUMBER: S. Petty

1. WELL LOCATION: (Show sketch of the location below)

Nearest Town: Newland County: AVERY

IVEY HEIGHT ROAD OFF OLD TOE RIVER

(Road, Community, or Subdivision and Lot No.)

2.

DEPTH DRILLING LOG
 From To Formation Description

0	40	DIRT
40	70	GRANITE
70	72	SHALE
72	152	GRANITE
152	153	SHALE
153	165	GRANITE

RECEIVED/ENTERED
 DIVISION OF ENVIRONMENTAL HEALTH SECTION
 99 AUG - 9 PM 3:09

3. DATE DRILLED 05/05/99 USE OF WELL PVT

4. TOTAL DEPTH 165'

5. CUTTINGS COLLECTED YES NO

6. DOES WELL REPLACE EXISTING WELL? YES NO

7. STATIC WATER LEVEL Below Top of Casing: 40 FT.

(Use "+" if Above Top of Casing)

8. TOP OF CASING IS 1 FT. Above Land Surface*

* Casing Terminated at/or below land surface is illegal unless a variance is issued
 In accordance with 15A NCAC 2C .0118

9. YIELD (gpm): 5 METHOD OF TEST AIR

10. WATER ZONES (depth): 2 gpm 70-72' 3 gpm 152-153'


11. CHLORINATION: Type HTH Amount 26 tabs

If additional space is needed use back of form

12. CASING:

LOCATION SKETCH

(Show direction and distance from at least two State Roads, or other map reference points)

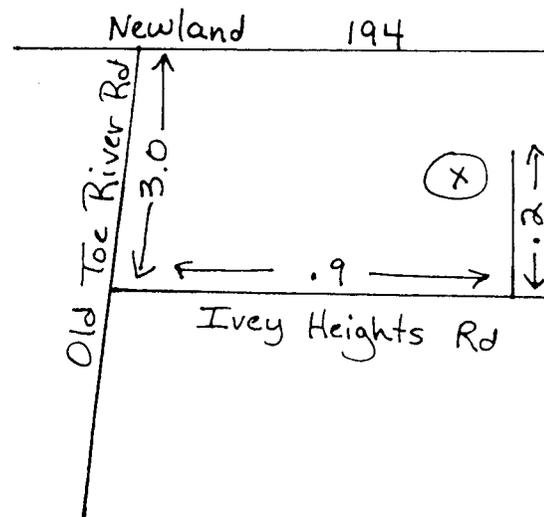

13. GROUT:

From	To	Depth	Material	Method
0	20	Ft.	CEMENT	PUMPED


14. SCREEN:

From	To	Depth	Diameter	Slot Size	Material
_____	_____	Ft.	in.	in.	_____

15. SAND/GRAVEL PACK:

From	To	Depth	Size	Material
_____	_____	Ft.	_____	_____

16. REMARKS:

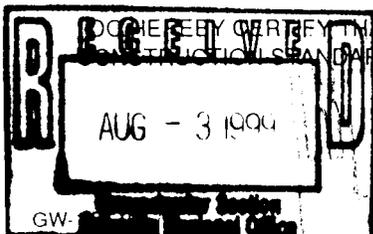

DO NOT CHECK OFF THIS WELL WAS CONSTRUCTED IN ACCORDANCE WITH 15A NCAC 2C, WELL CONSTRUCTION STANDARDS; AND THAT A COPY OF THIS RECORD HAS BEEN PROVIDED TO THE WELL OWNER.

Carolyn Isaacs

7/30/99

SIGNATURE OF CONTRACTOR OR AGENT

DATE

Submit original to Division of Environmental Management and copy to well owner.