

99255

FOR OFFICE USE ONLY
 QUAD NO. _____ SERIAL NO. **202660**
 Lat _____ Long _____ P. _____
 Minor Basin _____
 Basin Code _____
 Header Ent. _____ GW-1 Ent. _____

WELL CONSTRUCTION RECORD

DRILLING CONTRACTOR: ~~Dewey Wright Well & Pump Co. Inc.~~ **STATE WELL CONSTRUCTION**
 DRILLER REGISTRATION NUMBER: 266 PERMIT NUMBER: S Petty

1. WELL LOCATION: (Show sketch of the location below)

Nearest Town: Banner Elk County: AVERY

ON HWY 184 1.8 MI FROM 105

(Road, Community, or Subdivision and Lot No.)

2.

DEPTH		DRILLING LOG
From	To	Formation Description
0	7	DIRT
7	90	GRANITE
90	91	SHALE
91	185	GRANITE
185	186	SHALE
186	505	GRANITE

DINA GROUNDWATER SECTION
 RECEIVED OCT 14 AM 11:29

3. DATE DRILLED 06/01/99 USE OF WELL PVT

4. TOTAL DEPTH 505'

5. CUTTINGS COLLECTED YES NO

6. DOES WELL REPLACE EXISTING WELL? YES NO

7. STATIC WATER LEVEL Below Top of Casing: 50 FT.

(Use "+" if Above Top of Casing)

8. TOP OF CASING IS 1 FT. Above Land Surface*

* Casing Terminated at/or below land surface is illegal unless a variance is issued in accordance with 15A NCAC 2C .0118

9. YIELD (gpm): 3 METHOD OF TEST AIR

10. WATER ZONES (depth): 1 gpm 90-91' 2 gpm 185-186'

11. CHLORINATION: Type HTH Amount 93 tabs If additional space is needed use back of form

12. CASING:

From	To	Depth Ft.	Diameter	Wall Thickness or Weight/Ft.	Material
0	21		6 1/4	0.188	GALV

13. GROUT:

From	To	Depth Ft.	Material	Method
0	20		CEMENT	PUMPED


14. SCREEN:

From	To	Depth Ft.	Diameter	Slot Size	Material


15. SAND/GRAVEL PACK:

From	To	Depth Ft.	Size	Material

16. REMARKS:

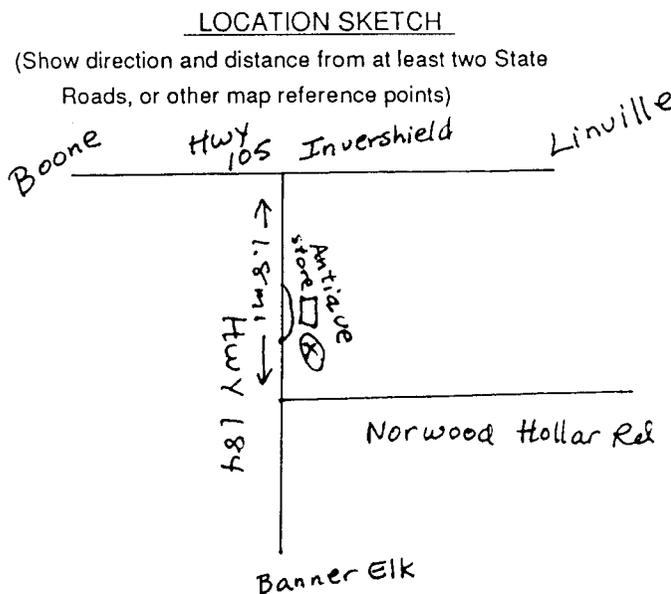

I DO HEREBY CERTIFY THAT THIS WELL WAS CONSTRUCTED IN ACCORDANCE WITH 15A NCAC 2C, WELL CONSTRUCTION STANDARDS, AND THAT A COPY OF THIS RECORD HAS BEEN PROVIDED TO THE WELL OWNER.

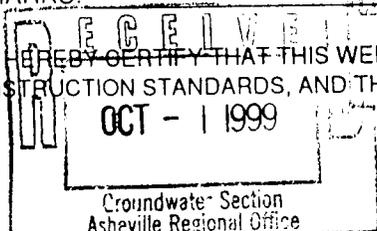

Lucy Chang
 SIGNATURE OF CONTRACTOR OR AGENT

9-29-99
 DATE