

99403

FOR OFFICE USE ONLY		204737
QUAD. NO.	SERIAL NO.	
Lat	Long	Pe
Minor Basin		
Basin Code		
Header Ent.	GW-1 Ent	

WELL CONSTRUCTION RECORD

DRILLING CONTRACTOR: Dewey Wright Well & Pump Co. Inc.

STATE WELL CONSTRUCTION

DRILLER REGISTRATION NUMBER: 266

PERMIT NUMBER: w. Reece

1. WELL LOCATION: (Show sketch of the location below)

Nearest Town: Linville County: AVERY
200' OFF OF 3 MILE RD 1.1 MILES FROM 221
 (Road, Community, or Subdivision and Lot No.)

2.

DEPTH	DEPTH		DRILLING LOG
	From	To	
	0	14	DIRT
	14	187	GRANITE
	187	188	QUARTZ
	188	305	GRANITE

99 DTC-7 NH 7:42

3. DATE DRILLED 07/26/99 USE OF WELL PVT

4. TOTAL DEPTH 305'

5. CUTTINGS COLLECTED YES NO

6. DOES WELL REPLACE EXISTING WELL? YES NO

7. STATIC WATER LEVEL Below Top of Casing: 40 FT.
 (Use "+" if Above Top of Casing)

8. TOP OF CASING IS 1 FT. Above Land Surface*

* Casing Terminated at/or below land surface is illegal unless a variance is issued in accordance with 15A NCAC 2C .0118 AIR

9. YIELD (gpm): 2 METHOD OF TEST _____

10. WATER ZONES (depth): 2 gpm 187-188'

11. CHLORINATION: Type HTH Amount 55 tabs


If additional space is needed use back of form

12. CASING:

Depth	Diameter	Wall Thickness or Weight/Ft.	Material
From <u>0</u> To <u>21</u> Ft.	<u>6 1/4</u>	<u>0.188</u>	<u>GALV</u>
From _____ To _____ Ft.	_____	_____	_____
From _____ To _____ Ft.	_____	_____	_____

LOCATION SKETCH

(Show direction and distance from at least two State Roads, or other map reference points)

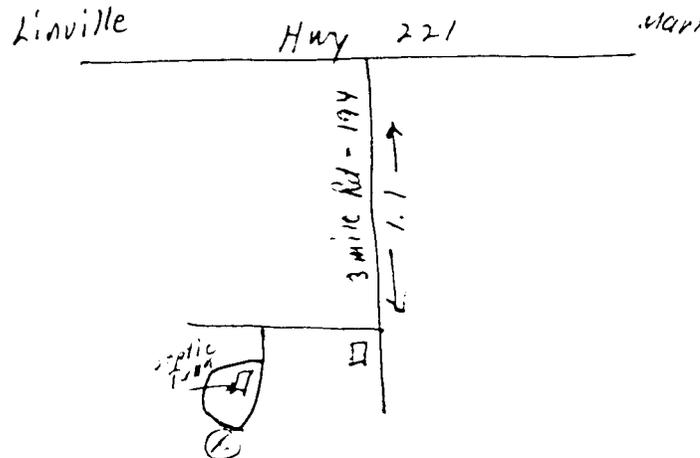

13. GROUT:

Depth	Material	Method
From <u>0</u> To <u>20</u> Ft.	<u>CEMENT</u>	<u>PUMPED</u>
From _____ To _____ Ft.	_____	_____

14. SCREEN:

Depth	Diameter	Slot Size	Material
From _____ To _____ Ft.	_____ in.	_____ in.	_____
From _____ To _____ Ft.	_____ in.	_____ in.	_____
From _____ To _____ Ft.	_____ in.	_____ in.	_____

15. SAND/GRAVEL PACK:

Depth	Size	Material
From _____ To _____ Ft.	_____	_____
From _____ To _____ Ft.	_____	_____

16. REMARKS:

RECEIVED
 NOV 29 1999
 Groundwater Section
 Asheville Regional Office

RECEIVED
 Signature: Barbara K. Caden
 Groundwater Section

DATE: 11/17/99
 SIGNATURE OF CONTRACTOR OR AGENT

DO HEREBY CERTIFY THAT THIS WELL WAS CONSTRUCTED IN ACCORDANCE WITH 15A NCAC 2C, WELL CONSTRUCTION STANDARDS AND THAT A COPY OF THIS RECORD HAS BEEN PROVIDED TO THE WELL OWNER.