

99347

FOR OFFICE USE ONLY		204738
QUAD. NO.	SERIAL NO.	
Lat.	Long.	
Minor Basin		
Basin Code		
Header Ent.	GW-1 Ent.	

**WELL CONSTRUCTION RECORD**

DRILLING CONTRACTOR: Dewey Wright Well & Pump Co. Inc.  
 DRILLER REGISTRATION NUMBER: 266 STATE WELL CONSTRUCTION PERMIT NUMBER: S. Price

1. WELL LOCATION: (Show sketch of the location below)  
 Nearest Town: Banner FKH County: AVERY  
.1 MI OFF BANNER CREEK RD NEAR 184  
 (Road, Community, or Subdivision and Lot No.)

2. DATE DRILLED 07/08/99 USE OF WELL PVT  
 3. TOTAL DEPTH 310'  
 4. CUTTINGS COLLECTED YES  NO   
 5. DOES WELL REPLACE EXISTING WELL? YES  NO   
 6. STATIC WATER LEVEL Below Top of Casing: 20 FT.  
 (Use "+" if Above Top of Casing)  
 7. TOP OF CASING IS 1 FT. Above Land Surface\*  
 \* Casing Terminated at or below land surface is illegal unless a variance is issued in accordance with 15A NCAC 2C .0118  
 8. YIELD (gpm): 100 METHOD OF TEST AIR  
 9. WATER ZONES (depth): 100 gpm 250-310'  
 10. CHLORINATION: Type HTH Amount 58 tabs  
 11. CASING:

DEPTH		DRILLING LOG Formation Description
From	To	
0	89	DIRT
89	105	LIMESTONE
105	170	BLUE LIMESTONE
170	250	GRANITE
250	310	LIMESTONE

12. GROUT:

From	To	Depth	Diameter	Wall Thickness or Weight/Ft.	Material
0	93	Ft.	6 1/4	0.188	GALV


13. SCREEN:

From	To	Depth	Diameter	Slot Size	Material
0	20	Ft.			CEMENT PUMPED

14. SAND/GRAVEL PACK:

From	To	Depth	Size	Material
		Ft.		

15. REMARKS:

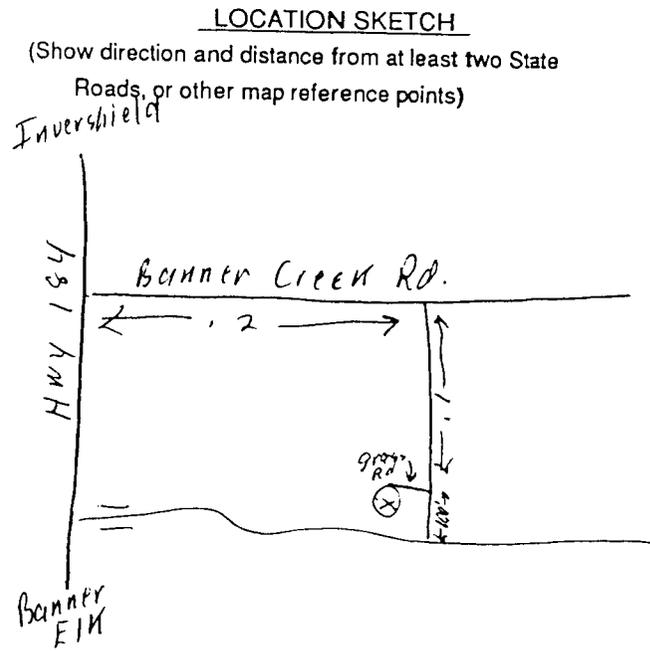

TO OPERBY CARTLEY THAT THIS WELL WAS CONSTRUCTED IN ACCORDANCE WITH 15A NCAC 2C, WELL CONSTRUCTION STANDARDS, AND THAT A COPY OF THIS RECORD HAS BEEN PROVIDED TO THE WELL OWNER.

NOV 29 1999

RECEIVED  
 DEC 1 1999

Groundwater Section  
 Asheville Regional Office

Barbara N. Aden  
 TITLE OF CONTRACTOR OR AGENT

DATE 11/17/99