

99294

FOR OFFICE USE ONLY		204739
QUAD. NO.	SERIAL NO.	
Lat	Long	
Minor Basin		
Basin Code		
Header Ent.	GW-1 Ent.	

WELL CONSTRUCTION RECORD

DRILLING CONTRACTOR: Dewey Wright Well & Pump Co., Inc.
 DRILLER REGISTRATION NUMBER: 266 STATE WELL CONSTRUCTION PERMIT NUMBER: S. Reece

1. WELL LOCATION: (Show sketch of the location below)
 Nearest Town: Boone County: AVERY
.3 MI OFF FLAT SPRINGS RD
 (Road, Community, or Subdivision and Lot No.)

DEPTH		DRILLING LOG
From	To	Formation Description
0	50	DIRT
50	250	GRANITE
250	253	SHALE
253	320	GRANITE

99 DEC -7 AM 7:42
DWD DIVISION/GENERAL SECTION

3. DATE DRILLED 06/17/99 USE OF WELL PVT
 4. TOTAL DEPTH 320'
 5. CUTTINGS COLLECTED YES NO
 6. DOES WELL REPLACE EXISTING WELL? YES NO
 7. STATIC WATER LEVEL Below Top of Casing: 80 FT.
 (Use "+" if Above Top of Casing)
 8. TOP OF CASING IS 1 FT. Above Land Surface*
 * Casing Terminated at/or below land surface is illegal unless a variance is issued in accordance with 15A NCAC 2C .0118
 9. YIELD (gpm): 1 METHOD OF TEST AIR
 10. WATER ZONES (depth): 1 gpm 250-253'

11. CHLORINATION: Type HTH Amount 48 tabs If additional space is needed use back of form

12. CASING:

From	To	Depth	Diameter	Wall Thickness or Weight/Ft.	Material	
From	To	0	54	6 1/4	0.188	GALV

13. GROUT:

From	To	Depth	Material	Method	
From	To	0	20	CEMENT	PUMPED


14. SCREEN:

From	To	Depth	Diameter	Slot Size	Material
From	To				

15. SAND/GRAVEL PACK:

From	To	Depth	Size	Material
From	To			

16. REMARKS:

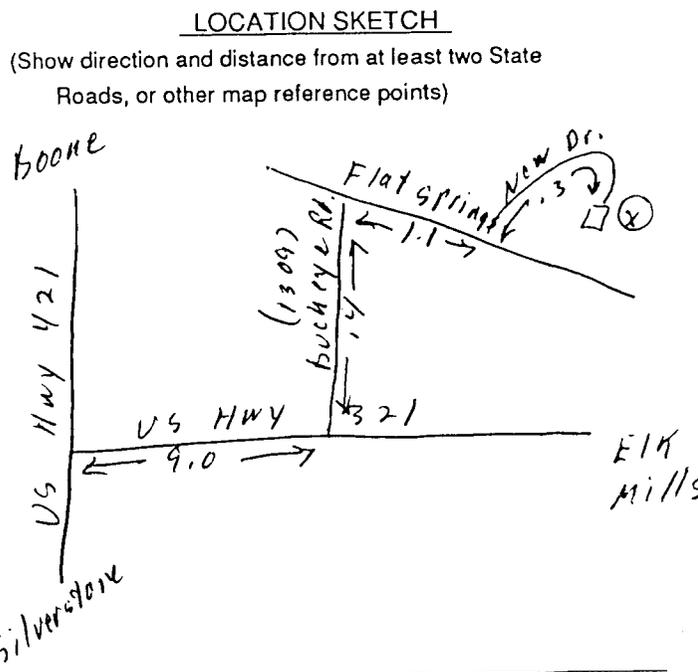

NO COPY OF THIS RECORD WILL BE PROVIDED TO THE WELL OWNER.

RECEIVED NOV 29 1999

FILED 330

Groundwater Section

SIGNATURE OF CONTRACTOR OR AGENT: Barbara K. Aden DATE: 11/17/99

Division of Environmental Management and copy to well owner.