


99409

205322

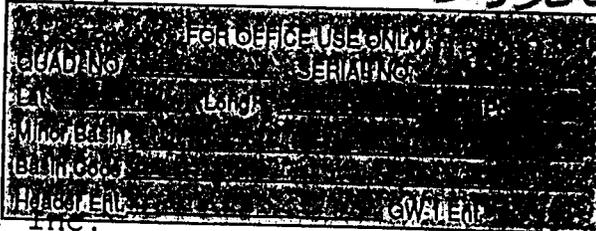

**WELL CONSTRUCTION RECORD**

DRILLING CONTRACTOR: Dewey Wright Well & Pump Co.

DRILLER REGISTRATION NUMBER: 266

STATE WELL CONSTRUCTION PERMIT NUMBER: W. Wilson

1. WELL LOCATION: (Show sketch of the location below)

Nearest Town: Banner Elk County: AVERY

OFF DARK RIDGE ROAD

(Road, Community, or Subdivision and Lot No.)

2.

DEPTH From To DRILLING LOG Formation Description

0	45	DIRT GRANITE
45	160	GRANITE/QUARTZ
160	161	GRANITE
161	230	GRANITE/QUARTZ
230	231	GRANITE
231	245	GRANITE

RECEIVED/DEBR  
DWD GROUNDWATER SECTION  
00 JAN -5 PM 3:27

3. DATE DRILLED 09/21/99 USE OF WELL PVT Zip Code \_\_\_\_\_

4. TOTAL DEPTH 245'

5. CUTTINGS COLLECTED YES  NO

6. DOES WELL REPLACE EXISTING WELL? YES  NO

7. STATIC WATER LEVEL Below Top of Casing: 60 FT.

8. TOP OF CASING IS 1 FT. Above Land Surface\* (Use "+" if Above Top of Casing)

Casing Terminated at/or below land surface is illegal unless a variance is issued in accordance with 15A NCAC 2C .0118

9. YIELD (gpm): 6 METHOD OF TEST AIR

0. WATER ZONES (depth): 1 gpm 160-161' 5 gpm 230-231'

1. CHLORINATION: Type HTH Amount 39 tabs

2. CASING: If additional space is needed use back of form

**LOCATION SKETCH**

(Show direction and distance from at least two State Roads, or other map reference points)

From	To	Depth	Diameter	Wall Thickness or Weight/Ft.	Material
0	51	Ft.	6 1/4	0.188	GALV

3. GROUT:

From	To	Depth	Material	Method
0	20	Ft.	CEMENT	PUMPED


4. SCREEN:

From	To	Depth	Diameter	Slot Size	Material
From	To	Ft.	in.	in.	

5. SAND/GRAVEL PACK:

From	To	Depth	Size	Material
From	To	Ft.		

REMARKS:

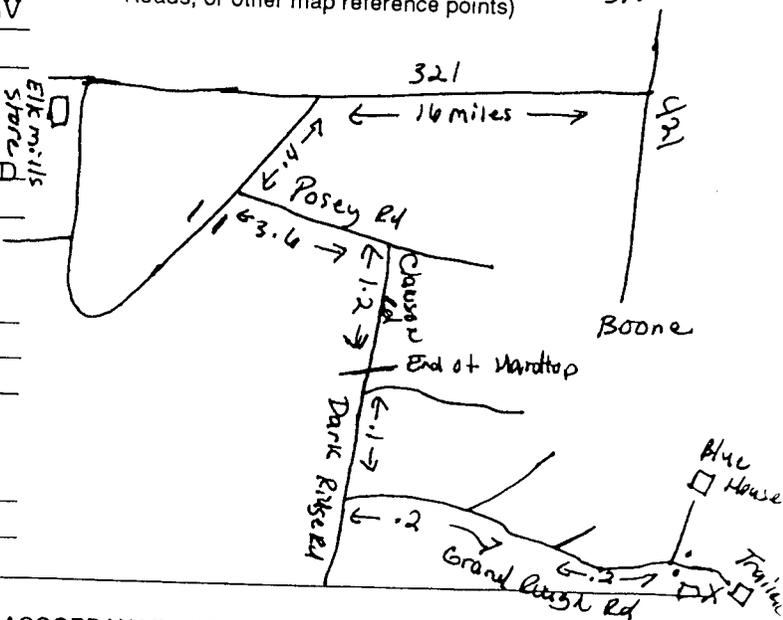

I HEREBY CERTIFY THAT THIS WELL WAS CONSTRUCTED IN ACCORDANCE WITH 15A NCAC 2C, WELL CONSTRUCTION STANDARDS, AND THAT A COPY OF THIS RECORD HAS BEEN PROVIDED TO THE WELL OWNER.

RECEIVED  
 JAN - 3 1999  
 Groundwater Section  
 Asheville Regional Office

SIGNATURE OF CONTRACTOR OR AGENT  
Mary Owens

DATE  
12/29/99