

99574 205324

FOR OFFICE USE ONLY

QUAD NO SERIAL NO

Miner Basin Basin Code Header Ent

WELL CONSTRUCTION RECORD

DRILLING CONTRACTOR: Dewey Wright Well & Pump Co STATE WELL CONSTRUCTION PERMIT NUMBER: K Jordan

DRILLER REGISTRATION NUMBER: 266

1. WELL LOCATION: (Show sketch of the location below)
 Nearest Town: Spruce Pine County: AVERY
OFF HANGING ROCK RD OFF 19E
 (Road, Community, or Subdivision and Lot No.)

DEPTH		DRILLING LOG Formation Description
From	To	
0	10	RD/DIRT
10	80	RD/BR/DIRT
80	90	SHALE/GRANITE
90	97	SHALE
97	170	GRANITE
170	173	SHALE
173	267	GRANITE
267	270	SHALE
270	420	Granite

RECEIVED/DEPT
DWD GROUNDWATER SECTION
00 JAN - 5 PM 3:2

2. _____
3. DATE DRILLED 09/06/99 USE OF WELL PVT
4. TOTAL DEPTH 420'
5. CUTTINGS COLLECTED YES NO
6. DOES WELL REPLACE EXISTING WELL? YES NO
7. STATIC WATER LEVEL Below Top of Casing: 70 FT.
 (Use "+" if Above Top of Casing)
8. TOP OF CASING IS 1 FT. Above Land Surface*
 * Casing Terminated at/or below land surface is illegal unless a variance is issued in accordance with 15A NCAC 2C .0118
9. YIELD (gpm): 1.5 METHOD OF TEST AIR
10. WATER ZONES (depth): 1.5 gpm 90-97'
11. CHLORINATION: Type HTH Amount 71 tabs
12. CASING: _____

From	To	Depth	Diameter	Wall Thickness or Weight/Ft.	Material
0	86	Ft.	6 1/4	0.188	GALV

13. GROUT:

From	To	Depth	Material	Method
0	20	Ft.	CEMENT	PUMPED


14. SCREEN:

From	To	Depth	Diameter	Slot Size	Material
_____	_____	_____ Ft.	_____ in.	_____ in.	_____

15. SAND/GRAVEL PACK:

From	To	Depth	Size	Material
_____	_____	_____ Ft.	_____	_____

6. REMARKS:

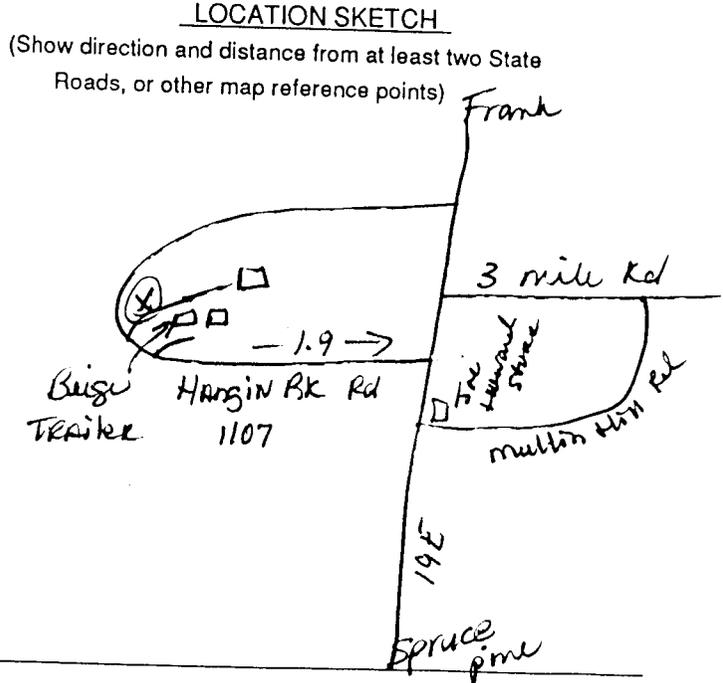

I HEREBY CERTIFY THAT THIS WELL WAS CONSTRUCTED IN ACCORDANCE WITH 15A NCAC 2C, WELL CONSTRUCTION STANDARDS, AND THAT A COPY OF THIS RECORD HAS BEEN PROVIDED TO THE WELL OWNER.

Groundwater Section
Asheville Regional Office

RECEIVED

JAN 10 2000

JAN - 3