

99 583 205 339
 FOR OFFICE USE ONLY
 QUAD NO. SERIAL NO.
 MINOR BASIN
 BASIN CODE
 HEADER ENT. G.WATER

WELL CONSTRUCTION RECORD

DRILLING CONTRACTOR: Dewey Wright Well & Pump Co. Inc.
 DRILLER REGISTRATION NUMBER: 266 STATE WELL CONSTRUCTION PERMIT NUMBER: K. Jordan

1. WELL LOCATION: (Show sketch of the location below)

Nearest Town: Spruce Pine County: AVERY
OFF BRUSHY CREEK OFF 19E BELOW JOE HOWEL
 (Road, Community, or Subdivision and Lot No.)

2.

DEPTH		DRILLING LOG
From	To	Formation Description
0	8	RD DRT/GRY CLAY
8	56	RD CLAY MUD
56	90	GRANITE
90	93	SHALE
93	189	GRANITE
189	192	WHT QUARTZ/FLINT
192	208	GRANITE
208	209	GRANT/FLINT
209	222	GRANITE

RECEIVED/GENERAL SECTION
 JAN - 5 PM 3:20

3. DATE DRILLED 09/04/99 USE OF WELL PVT
 4. TOTAL DEPTH 222'
 5. CUTTINGS COLLECTED YES NO
 6. DOES WELL REPLACE EXISTING WELL? YES NO
 7. STATIC WATER LEVEL Below Top of Casing: 50 FT.
 (Use "+" if Above Top of Casing)
 8. TOP OF CASING IS 1 FT. Above Land Surface*

* Casing Terminated at/or below land surface is illegal unless a variance is issued in accordance with 15A NCAC 2C .0118

9. YIELD (gpm): _____ METHOD OF TEST AIR
 10. WATER ZONES (depth): 1 gpm 90-93', 5 gpm 189-192', 54 gpm 208-209'

11. CHLORINATION: Type HTH Amount 36 tabs
 12. CASING:


From	To	Depth	Diameter	Wall Thickness or Weight/Ft.	Material
0	63	Ft.	6 1/4	0.188	GALV

13. GROUT:
 From 0 To 20 Ft. Material CEMENT Method PUMPED

14. SCREEN:
 From _____ To _____ Ft. Diameter _____ in. Slot Size _____ in. Material _____

15. SAND/GRAVEL PACK:
 From _____ To _____ Ft. Size _____ Material _____

16. REMARKS:

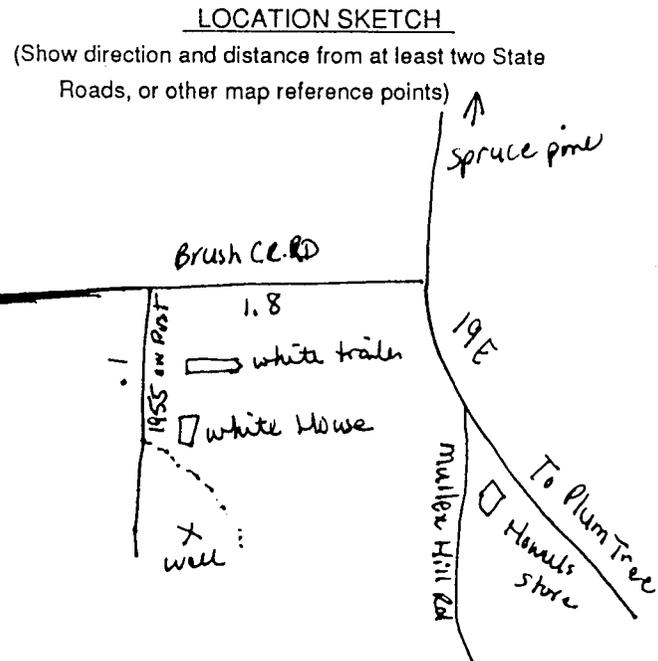

I DO HEREBY CERTIFY THAT THIS WELL WAS CONSTRUCTED IN ACCORDANCE WITH 15A NCAC 2C, WELL CONSTRUCTION STANDARDS AND THAT A COPY OF THIS RECORD HAS BEEN PROVIDED TO THE WELL OWNER.

RECEIVED JAN - 31 1999
 Groundwater Section OF CONTRACTOR OR AGENT Mary Owens DATE 12/28/99
 Asheville Regional Office
 Groundwater Section, Division of Environmental Management and copy to well owner.