

99 489

FOR OFFICE USE ONLY **205356**

QUAD. NO. _____ SERIAL NO. _____
 Lat. _____ Long. _____ Elevation _____
 Minor Basin _____
 Basin Code _____
 Header Ent. _____ GW-1 Ent. _____

WELL CONSTRUCTION RECORD

DRILLING CONTRACTOR: Dewey Wright Well & Pump Co. INC

DRILLER REGISTRATION NUMBER: 266

STATE WELL CONSTRUCTION

PERMIT NUMBER: K. Jordan

1. WELL LOCATION: (Show sketch of the location below)

Nearest Town: Newland County: AVERY

ON OLD HOTEL RD. OFF I9E

(Road, Community, or Subdivision and Lot No.)

2.

DEPTH DRILLING LOG
 From To Formation Description

0	8	RED CLAY
8	56	BROWN DIRT
56	92	SHALE ROCK/QUARTZ
92	97	SHALE ROCK
97	128	QUARTZ/WHT QURTZ
128	133	SHALE ROCK
133	400	WHT/PINK QUARTZ

3. DATE DRILLED 08/12/99 USE OF WELL PVT

4. TOTAL DEPTH 400'

5. CUTTINGS COLLECTED YES NO

6. DOES WELL REPLACE EXISTING WELL? YES NO

7. STATIC WATER LEVEL Below Top of Casing: 60 FT.

(Use "+" if Above Top of Casing)

8. TOP OF CASING IS 1 FT. Above Land Surface*

* Casing Terminated at/or below land surface is illegal unless a variance is issued in accordance with 15A NCAC 2C .0118

9. YIELD (gpm): 2.5 METHOD OF TEST AIR

10. WATER ZONES (depth): 1 gpm 92-97' 1.5 gpm 128-133'

11. CHLORINATION: Type HTH Amount 69 tabs

If additional space is needed use back of form

12. CASING:

Depth	Diameter	Wall Thickness or Weight/Ft.	Material
From _____ To _____ Ft.	_____	_____	_____
From <u>0</u> To <u>84</u> Ft.	<u>6 1/4</u>	<u>0.188</u>	<u>GALV.</u>
From _____ To _____ Ft.	_____	_____	_____

13. GROUT:

Depth	Material	Method
From <u>0</u> To <u>20</u> Ft.	<u>CEMENT</u>	<u>PUMPED</u>
From _____ To _____ Ft.	_____	_____

14. SCREEN:

Depth	Diameter	Slot Size	Material
From _____ To _____ Ft.	_____ in.	_____ in.	_____
From _____ To _____ Ft.	_____ in.	_____ in.	_____
From _____ To _____ Ft.	_____ in.	_____ in.	_____


15. SAND/GRAVEL PACK:

Depth	Size	Material
From _____ To _____ Ft.	_____	_____
From _____ To _____ Ft.	_____	_____

16. REMARKS:

LOCATION SKETCH

(Show direction and distance from at least two State Roads, or other map reference points)

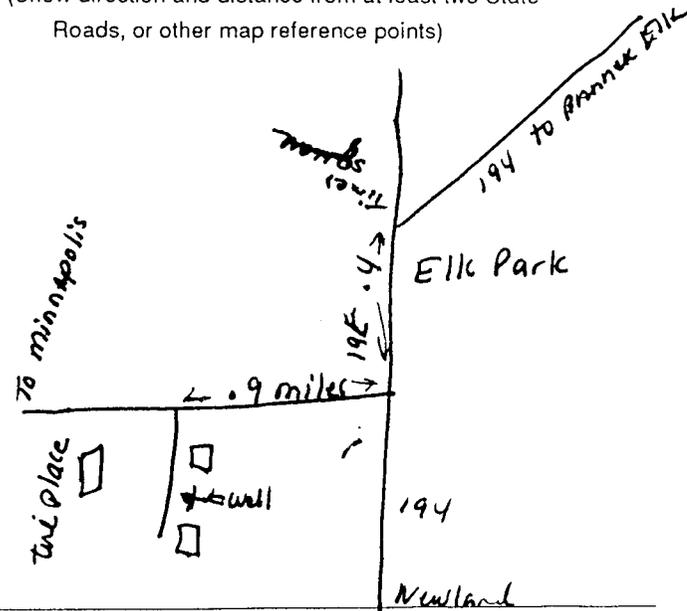

00 JAN -5 PM 3:26

RECEIVED
 JAN 9 2000
 Asheville Regional Office

RECEIVED
 DEC 28 1999

Barbara K. Aden
 SIGNATURE OF CONTRACTOR OR AGENT

12/21/99
 DATE

I HEREBY CERTIFY THAT THIS WELL WAS CONSTRUCTED IN ACCORDANCE WITH 15A NCAC 2C, WELL CONSTRUCTION STANDARDS, AND THAT A COPY OF THIS RECORD HAS BEEN PROVIDED TO THE WELL OWNER.