

FOR OFFICE USE ONLY  
 QUAD NO. SERIAL NO.  
 Lat. Long. RO.  
 Minor Basin  
 Basin Code  
 Header Ent. GW Ent.

**WELL CONSTRUCTION RECORD**

DRILLING CONTRACTOR: BRASWELL Well Drilling

STATE WELL CONSTRUCTION

205369

DRILLER REGISTRATION NUMBER: 163

PERMIT NUMBER:

1. WELL LOCATION: (Show sketch of the location below)

Nearest Town: Ingram's County: Avery

Bent Rd.

(Road, Community, or Subdivision and Lot No.)

DEPTH

From To

0 - 33  
33 - 320

DRILLING LOG

Formation Description

dent  
mica schists

2.

3. DATE DRILLED 11-1-99 USE OF WELL Residential

4. TOTAL DEPTH 320

5. CUTTINGS COLLECTED YES  NO

6. DOES WELL REPLACE EXISTING WELL? YES  NO

7. STATIC WATER LEVEL Below Top of Casing: \_\_\_\_\_ FT.

(Use "+" if Above Top of Casing)

8. TOP OF CASING IS 1 FT. Above Land Surface\*

\* Casing Terminated at/or below land surface is illegal unless a variance is issued in accordance with 15A NCAC 2C .0118

9. YIELD (gpm): 30 METHOD OF TEST Blown

10. WATER ZONES (depth): 150, 240, 297 ft.

11. CHLORINATION: Type Chlorine Amount 3 tabs

12. CASING:

If additional space is needed use back of form

LOCATION SKETCH

(Show direction and distance from at least two State Roads, or other map reference points)

From	Depth	To	Diameter	Wall Thickness or Weight/Ft	Material
	<u>0</u>	<u>37</u>	<u>6 5/8</u>	<u>1.855</u>	<u>galv</u>

13. GROUT:

From	Depth	To	Material	Method
	<u>0</u>	<u>20</u>	<u>cement</u>	<u>packed</u>

14. SCREEN:



From	Depth	To	Diameter	Slot Size	Material

15. SAND/GRAVEL PACK:

From	Depth	To	Size	Material

16. REMARKS:

I DO HEREBY CERTIFY THAT THIS WELL WAS CONSTRUCTED IN ACCORDANCE WITH 15A NCAC 2C, WELL CONSTRUCTION STANDARDS, AND THAT A COPY OF THIS RECORD HAS BEEN PROVIDED TO THE WELL OWNER.

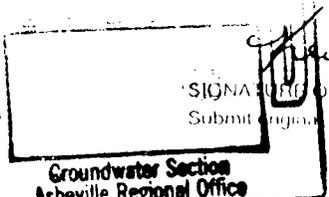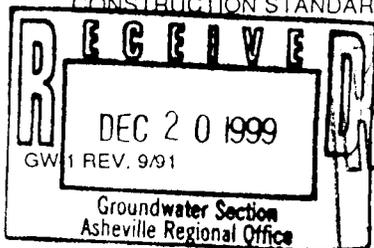

11-1-99

SIGNATURE OF CONTRACTOR OR AGENT

DATE

Submit original to Division of Environmental Management and copy to well owner.