

99648

FOR OFFICE USE ONLY		205370
QUAD. NO.	SERIAL NO.	
Lat.	Long.	Pc.
Minor Basin		
Basin Code		
Header Ent.	GW-1 Ent	

WELL CONSTRUCTION RECORD

DRILLING CONTRACTOR: Dewey Wright Well & Pump Co. LLC STATE WELL CONSTRUCTION

DRILLER REGISTRATION NUMBER: 266 PERMIT NUMBER: K. Jordan

1. WELL LOCATION: (Show sketch of the location below)

Nearest Town: Newland County: AVERY

OFF RHONEYS VIEW RD.
 (Road, Community, or Subdivision and Lot No.)

2.

DEPTH		DRILLING LOG
From	To	Formation Description
0	105	DIRT/ LMSTN
105	390	GRANITE
390	391	CRVCS/GRNT/PNK QURT'Z
391	420	GRANITE

RECEIVED 01 JAN 5 PM 3:27
NO GROUNDWATER SECTION

3. DATE DRILLED 09/28/99 USE OF WELL pvt

4. TOTAL DEPTH 420'

5. CUTTINGS COLLECTED YES NO

6. DOES WELL REPLACE EXISTING WELL? YES NO

7. STATIC WATER LEVEL Below Top of Casing: 100 FT.
 (Use "*" if Above Top of Casing)

8. TOP OF CASING IS _____ FT. Above Land Surface*

* Casing Terminated at/or below land surface is illegal unless a variance is issued in accordance with 15A NCAC 2C .0118

9. YIELD (gpm): 3 METHOD OF TEST AIR

10. WATER ZONES (depth):
3 gpm 390-391'

11. CHLORINATION: Type HTH Amount 65 tabs

If additional space is needed use back of form

12. CASING:

Depth	Diameter	Wall Thickness or Weight/Ft.	Material
From _____ To _____ Ft.			
From <u>0</u> To <u>105</u> Ft.	<u>6 1/4</u>	<u>0.188</u>	<u>GALV.</u>
From _____ To _____ Ft.			

13. GROUT:

Depth	Material	Method
From _____ To _____ Ft.		
From <u>0</u> To <u>20</u> Ft.	<u>CEMENT</u>	<u>PUMPED</u>
From _____ To _____ Ft.		

14. SCREEN:

Depth	Diameter	Slot Size	Material
From _____ To _____ Ft.			
From _____ To _____ Ft.			
From _____ To _____ Ft.			


15. SAND/GRAVEL PACK:

Depth	Size	Material
From _____ To _____ Ft.		
From _____ To _____ Ft.		

16. REMARKS:

LOCATION SKETCH

(Show direction and distance from at least two State Roads, or other map reference points)

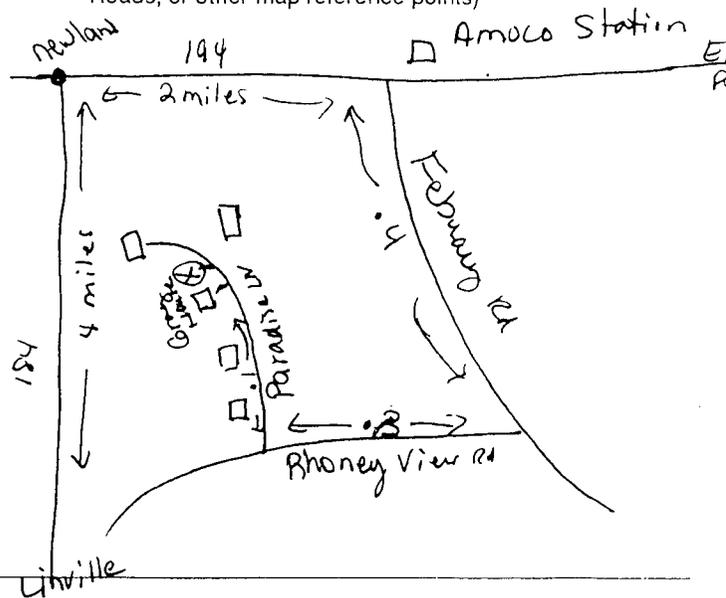

RECEIVED
 JAN - 5 1999
 RECEIVED
 JAN 5 1999
 Groundwater Section Asheville Regional Office

SIGNATURE OF CONTRACTOR OR AGENT
Mary Owens

DATE
12-29-99