

49720

FOR OFFICE USE ONLY **200362**

QUAD. NO. \_\_\_\_\_ SERIAL NO. \_\_\_\_\_  
 Lat. \_\_\_\_\_ Long. \_\_\_\_\_ Pc \_\_\_\_\_  
 Minor Basin \_\_\_\_\_  
 Basin Code \_\_\_\_\_  
 Header Ent. \_\_\_\_\_ GW-1 Ent. \_\_\_\_\_

**WELL CONSTRUCTION RECORD**

DRILLING CONTRACTOR: Dewey Wright Well & Pump Service, LLC

DRILLER REGISTRATION NUMBER: 366 PERMIT NUMBER: Ki Jordan

1. WELL LOCATION: (Show sketch of the location below)  
 Nearest Town: Elk Park County: \_\_\_\_\_

**AVERY**

2. OFF MILES FIELD RD.  
 (Road, Community, or Subdivision and Lot No.)

DEPTH		DRILLING LOG
From	To	Formation Description
0	6	BLK. DIRT
6	30	GRANITE
30	32	SHALE ROCK
32	600	GRNT/WHT&PK QURTZ

FEB - 3 AM 10:22

3. DATE DRILLED: 10/14/99 USE OF WELL: PVT

4. TOTAL DEPTH: 600'

5. CUTTINGS COLLECTED YES  NO

6. DOES WELL REPLACE EXISTING WELL? YES  NO

7. STATIC WATER LEVEL Below Top of Casing: 30 FT.  
 (Use "+" if Above Top of Casing)

8. TOP OF CASING IS \_\_\_\_\_ FT. Above Land Surface\*

\* Casing Terminated at/or below land surface is illegal unless a variance is issued in accordance with 15A NCAC 2C .0118

9. YIELD (gpm): 1/4 METHOD OF TEST: AIR

10. WATER ZONES (depth):  
1/4 gpm 30-32'

11. CHLORINATION: Type HTH Amount 116 tabs

12. CASING: \_\_\_\_\_

If additional space is needed use back of form

**LOCATION SKETCH**

(Show direction and distance from at least two State Roads, or other map reference points)



Depth	Diameter	Wall Thickness or Weight/Ft.	Material
From _____ To _____ Ft.	_____	_____	_____
From <u>0</u> To <u>21</u> Ft.	<u>6 1/4</u>	<u>0.188</u>	<u>GALV.</u>
From _____ To _____ Ft.	_____	_____	_____

Depth	Material	Method
From _____ To _____ Ft.	_____	_____
From <u>0</u> To <u>20</u> Ft.	<u>CEMENT</u>	<u>PUMPED</u>

Depth	Diameter	Slot Size	Material
From _____ To _____ Ft.	_____	_____	_____
From _____ To _____ Ft.	_____	_____	_____
From _____ To _____ Ft.	_____	_____	_____

Depth	Size	Material
From _____ To _____ Ft.	_____	_____
From _____ To _____ Ft.	_____	_____

16. REMARKS: \_\_\_\_\_

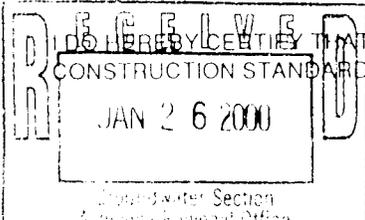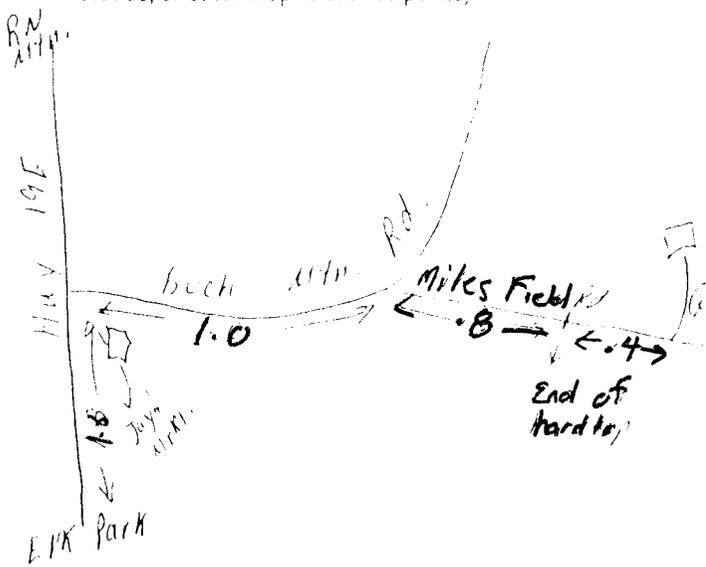

I DO HEREBY CERTIFY THAT THIS WELL WAS CONSTRUCTED IN ACCORDANCE WITH 15A NCAC 2C, WELL CONSTRUCTION STANDARDS, AND THAT A COPY OF THIS RECORD HAS BEEN PROVIDED TO THE WELL OWNER.

Barbara K. Aiden 1/22/00  
 SIGNATURE OF CONTRACTOR OR AGENT DATE