

99702

FOR OFFICE USE ONLY		200303
QUAD. NO.	_____	SERIAL NO.
Lat	_____	Long.
Minor Basin	_____	
Basin Code	_____	
Header Ent.	_____	GW-1 Ent.

WELL CONSTRUCTION RECORD

DRILLING CONTRACTOR: Dewey Wright Well & Pump Co., Inc.
 DRILLER REGISTRATION NUMBER: 266 STATE WELL CONSTRUCTION PERMIT NUMBER: S. Reece


1. WELL LOCATION: (Show sketch of the location below)
 Nearest Town: FLK Mills County: AVERY
OFF PHILLIPS RDOFF BEECH CRK RD. OFF 321
(Road, Community, or Subdivision and Lot No.)

2. DATE DRILLED 10/11/99 USE OF WELL PVT Zip Code _____
 4. TOTAL DEPTH 205'
 5. CUTTINGS COLLECTED YES NO
 6. DOES WELL REPLACE EXISTING WELL? YES NO
 7. STATIC WATER LEVEL Below Top of Casing: 10 FT.
(Use "+" if Above Top of Casing)
 8. TOP OF CASING IS 1 FT. Above Land Surface*
* Casing Terminated at/or below land surface is illegal unless a variance is issued in accordance with 15A NCAC 2C .0118
 9. YIELD (gpm): 5 METHOD OF TEST AIR
 10. WATER ZONES (depth): 2 gpm 70-73' 3 gpm 170-173'
 11. CHLORINATION: Type HTH Amount 42 tabs
 12. CASING: _____

DEPTH		DRILLING LOG Formation Description
From	To	
0	36	DIRT
36	70	GRANITE
70	73	SHALE
73	170	GRANITE
170	173	QUARTZ
173	205	GRANITE

00 FEB - 3 AM 10:22

13. GROUT:
- | From | To | Depth | Diameter | Wall Thickness or Weight/Ft. | Material |
|------|----|-------|----------|------------------------------|----------|
| 0 | 42 | Ft. | 6 1/4 | 0.188 | GALV. |
14. SCREEN:
- | From | To | Depth | Diameter | Slot Size | Material |
|------|----|-------|----------|-----------|----------|
| 0 | 20 | Ft. | | | CEMENT |
15. SAND/GRAVEL PACK:
- | From | To | Depth | Size | Material |
|------|----|-------|------|----------|
| 0 | 20 | Ft. | | |
6. REMARKS: _____

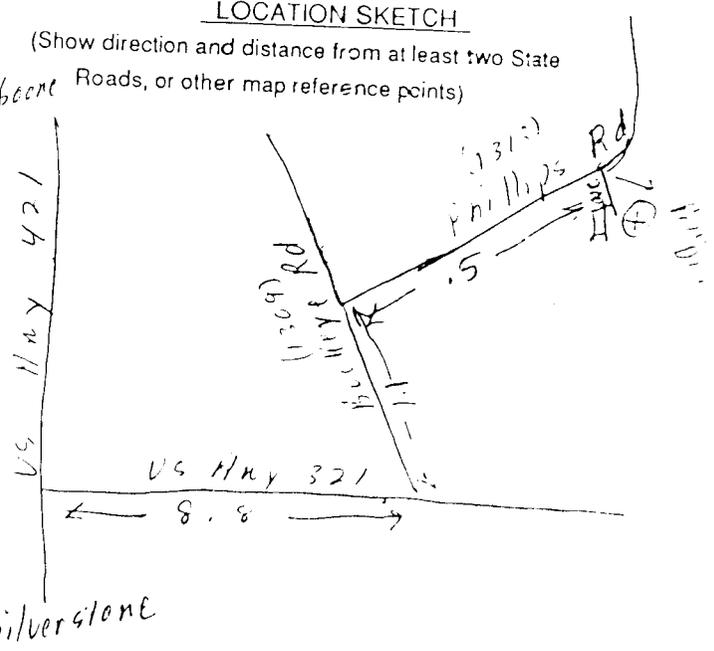

I DO HEREBY CERTIFY THAT THIS WELL WAS CONSTRUCTED IN ACCORDANCE WITH 15A NCAC 2C, WELL CONSTRUCTION STANDARDS, AND THAT A COPY OF THIS RECORD HAS BEEN PROVIDED TO THE WELL OWNER.

JAN 26 2000

Maureen K. Ayles SIGNATURE OF CONTRACTOR OR AGENT
 DATE 1/21/00

Submit original to Division of Environmental Management and copy to well owner