

99 797

FOR OFFICE USE ONLY 206527

QUAD. NO. \_\_\_\_\_ SERIAL NO. \_\_\_\_\_

Lat. \_\_\_\_\_ Long. \_\_\_\_\_ Pc \_\_\_\_\_

Minor Basin \_\_\_\_\_

Basin Code \_\_\_\_\_

Header Ent. \_\_\_\_\_ GW:1 Ent \_\_\_\_\_

**WELL CONSTRUCTION RECORD**

DRILLING CONTRACTOR: ~~Dewey Wright Well & Pump Co. Inc.~~ STATE WELL CONSTRUCTION

DRILLER REGISTRATION NUMBER: 266 PERMIT NUMBER: S. Petty

1. WELL LOCATION: (Show sketch of the location below)

Nearest Town: EIK Park County: AVERY

TUCKER HOLLOW RD OFF 19E

(Road, Community, or Subdivision and Lot No.)

DEPTH DRILLING LOG  
 From To Formation Description

0	80	DIRT
80	145	GRANITE
145	146	SHALE
146	187	GRANITE
187	189	QUARTZ
189	205	GRANITE

00 FEB - 8 AM 11: 00  
 STATE WELL CONSTRUCTION SECTION

3. DATE DRILLED 11/30/99 USE OF WELL PVT

4. TOTAL DEPTH 205'

5. CUTTINGS COLLECTED YES  NO

6. DOES WELL REPLACE EXISTING WELL? YES  NO

7. STATIC WATER LEVEL Below Top of Casing: 30 FT.

(Use "+" if Above Top of Casing)

8. TOP OF CASING IS 1 FT. Above Land Surface\*

\* Casing Terminated at/or below land surface is illegal unless a variance is issued in accordance with 15A NCAC 2C .0118

9. YIELD (gpm): 6 METHOD OF TEST AIR

10. WATER ZONES (depth): 2 gpm 145-146' 4 gpm 187-189'


11. CHLORINATION: Type HTH Amount 37 tabs

If additional space is needed use back of form

12. CASING:

LOCATION SKETCH

(Show direction and distance from at least two State Roads, or other map reference points)

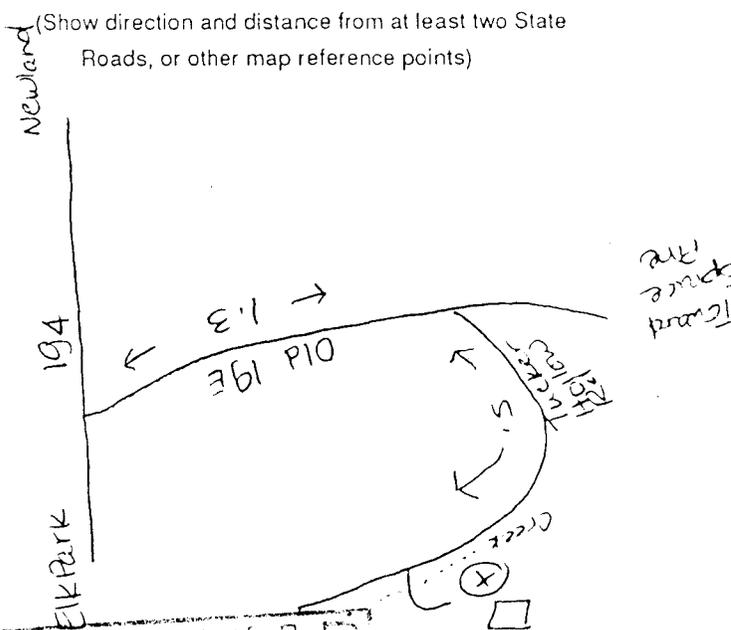

13. GROUT:

From	To	Ft.	Material	Method
0	20		CEMENT	PUMPED


14. SCREEN:

From	To	Ft.	Diameter	Slot Size	Material

15. SAND/GRAVEL PACK:

From	To	Ft.	Depth	Size	Material

16. REMARKS:

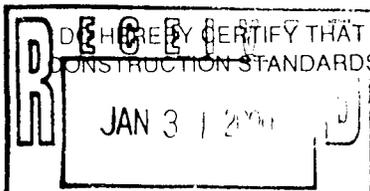

DRILLER CERTIFY THAT THIS WELL WAS CONSTRUCTED IN ACCORDANCE WITH 15A NCAC 2C, WELL CONSTRUCTION STANDARDS, AND THAT A COPY OF THIS RECORD HAS BEEN PROVIDED TO THE WELL OWNER.

Angi Greene

1.25.00

SIGNATURE OF CONTRACTOR OR AGENT

DATE

Submit original to Division of Environmental Management and copy to well owner.