

99 775

FOR OFFICE USE ONLY  
 QUAD. NO. \_\_\_\_\_ SERIAL NO. 206528  
 Lat. \_\_\_\_\_ Long. \_\_\_\_\_ Pc \_\_\_\_\_  
 Minor Basin \_\_\_\_\_  
 Basin Code \_\_\_\_\_  
 Header Ent. \_\_\_\_\_ GW-1 Ent. \_\_\_\_\_

**WELL CONSTRUCTION RECORD**

DRILLING CONTRACTOR: Dewey Wright Well & Pump Co STATE WELL CONSTRUCTION  
 DRILLER REGISTRATION NUMBER: 266 PERMIT NUMBER: Steve Reece

1. WELL LOCATION: (Show sketch of the location below)  
 Nearest Town: Eik Mills County: AVERY

SOUTH CREST RD OFF BEECH MTN. PARKWAY  
 (Road, Community, or Subdivision and Lot No.)

DEPTH		DRILLING LOG
From	To	Formation Description
0	20	DIRT
20	30	GRANITE
30	34	SHALE
34	80	GRANITE
80	83	SHALE
83	220	GRANITE

00 FEB - 8 AM 11:00

2. City or Town \_\_\_\_\_
3. DATE DRILLED 11/29/99 USE OF WELL PVT
4. TOTAL DEPTH 220'
5. CUTTINGS COLLECTED YES  NO
6. DOES WELL REPLACE EXISTING WELL? YES  NO
7. STATIC WATER LEVEL Below Top of Casing: 40 FT.  
 (Use "+" if Above Top of Casing)
8. TOP OF CASING IS 1 FT. Above Land Surface\*  
 \* Casing Terminated at/or below land surface is illegal unless a variance is issued in accordance with 15A NCAC 2C .0118
9. YIELD (gpm): 15 METHOD OF TEST AIR
10. WATER ZONES (depth): 15 gpm 80-83'

11. CHLORINATION: Type HTH Amount 38 tabs

12. CASING:

If additional space is needed use back of form

Depth	Diameter	Wall Thickness or Weight/Ft.	Material
From _____ To _____ Ft.			
From <u>0</u> To <u>26</u> Ft.	<u>6 1/4</u>	<u>0.188</u>	<u>GALV</u>
From _____ To _____ Ft.			

13. GROUT:

Depth	Material	Method
From <u>0</u> To <u>20</u> Ft.	<u>CEMENT</u>	<u>PUMPED</u>
From _____ To _____ Ft.		

14. SCREEN:

Depth	Diameter	Slot Size	Material
From _____ To _____ Ft.			
From _____ To _____ Ft.			
From _____ To _____ Ft.			


15. SAND/GRAVEL PACK:

Depth	Size	Material
From _____ To _____ Ft.		
From _____ To _____ Ft.		

16. REMARKS:

LOCATION SKETCH

(Show direction and distance from at least two State Roads, or other map reference points)

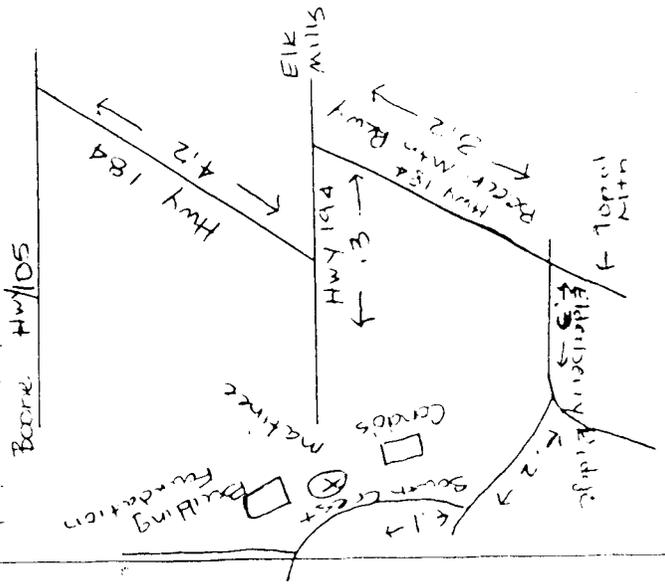

I DO HEREBY CERTIFY THAT THIS WELL WAS CONSTRUCTED IN ACCORDANCE WITH 15A NCAC 2C, WELL CONSTRUCTION STANDARDS, AND THAT A COPY OF THIS RECORD HAS BEEN PROVIDED TO THE WELL OWNER

JAN 31 2000  
 Groundwater Section  
 508 Regional Office

Angi Greene  
 SIGNATURE OF CONTRACTOR OR AGENT  
 DATE 1-25-00  
 Submit original to Division of Environmental Management and copy to well owner