

99 856

FOR OFFICE USE ONLY SERIAL NO. **206529**  
 QUAD. NO. \_\_\_\_\_ SERIAL NO. \_\_\_\_\_  
 Lat. \_\_\_\_\_ Long. \_\_\_\_\_ Pc \_\_\_\_\_  
 Minor Basin \_\_\_\_\_  
 Basin Code \_\_\_\_\_  
 Header Ent. \_\_\_\_\_ GW-1 Ent. \_\_\_\_\_

**WELL CONSTRUCTION RECORD**

DRILLING CONTRACTOR: Dewey Wright Well & Pump Co. STATE WELL CONSTRUCTION  
 DRILLER REGISTRATION NUMBER: 266 PERMIT NUMBER: Kenny Jordan

1. WELL LOCATION: (Show sketch of the location below)  
 Nearest Town: Boone County: AVERY  
BUCKEYE RD 7/10 MILE FROM HWY 321N.  
 (Road, Community, or Subdivision and Lot No.)

2. \_\_\_\_\_  
 3. DATE DRILLED 11/24/99 USE OF WELL PVT  
 4. TOTAL DEPTH 420'  
 5. CUTTINGS COLLECTED YES  NO   
 6. DOES WELL REPLACE EXISTING WELL? YES  NO   
 7. STATIC WATER LEVEL Below Top of Casing: 60 FT.  
 (Use "+" if Above Top of Casing)  
 8. TOP OF CASING IS 1 FT. Above Land Surface\*  
 \* Casing Terminated at/or below land surface is illegal unless a variance is issued  
 in accordance with 15A NCAC 2C .0118  
 9. YIELD (gpm): 1 METHOD OF TEST AIR  
 10. WATER ZONES (depth): 1/4 gpm 31-42' 1/4 gpm 210-215'  
1/2 gpm 340-341'  
 11. CHLORINATION: Type HTH Amount 72 tabs  
 12. CASING:

DEPTH		DRILLING LOG
From	To	Formation Description
0	12	RED, BROWN SLATE
12	31	GRANITE
31	42	SHALE ROCK
42	210	GRANITE, WHITE QRTZ
210	215	WHITE QUARTZ
215	340	GRANITE, WHITE QRTZ
340	341	FLINT, WHITE QUARTZ
341	420	GRANITE

NO CUTTINGS COLLECTED

13. GROUT:

Depth	Diameter	Wall Thickness or Weight/Ft.	Material
From 0 To 21 Ft.	6 1/4	0.188	GALV


14. SCREEN:

Depth	Diameter	Slot Size	Material
From 0 To 20 Ft.			CEMENT PUMPED

15. SAND/GRAVEL PACK:

Depth	Size	Material
From _____ To _____ Ft.		

16. REMARKS:

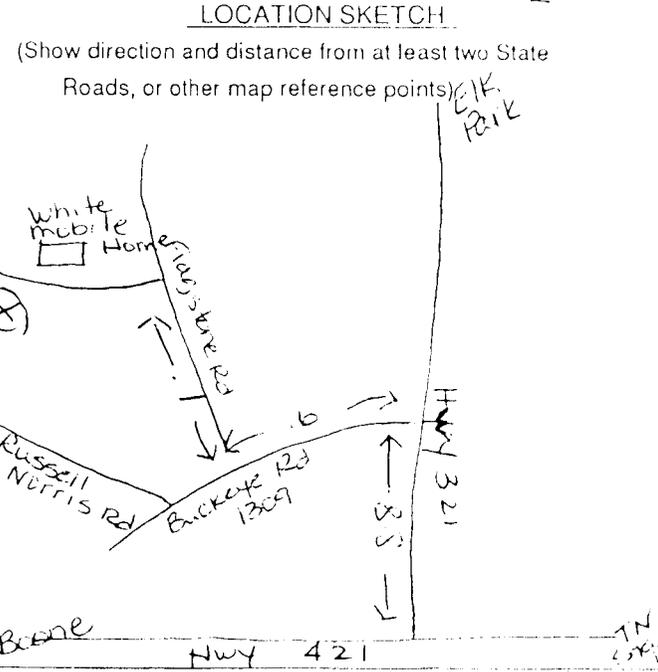

I DO HEREBY CERTIFY THAT THIS WELL WAS CONSTRUCTED IN ACCORDANCE WITH 15A NCAC 2C, WELL CONSTRUCTION STANDARDS, AND THAT A COPY OF THIS RECORD HAS BEEN PROVIDED TO THE WELL OWNER.

JAN 31 2000  
 GW-1 REV. 5/01

Angi Greene SIGNATURE OF CONTRACTOR OR AGENT  
 DATE 1-25-00