

99 770

FOR OFFICE USE ONLY **200530**

QUAD. NO. \_\_\_\_\_ SERIAL NO. \_\_\_\_\_

Lat \_\_\_\_\_ Long \_\_\_\_\_ Pc \_\_\_\_\_

Minor Basin \_\_\_\_\_

Basin Code \_\_\_\_\_

Header Ent. \_\_\_\_\_ GW-1 Ent \_\_\_\_\_

**WELL CONSTRUCTION RECORD**

DRILLING CONTRACTOR: Dewey Wright Well & Pump Co STATE WELL CONSTRUCTION  
 DRILLER REGISTRATION NUMBER: 266 PERMIT NUMBER: Steve Reece

1. WELL LOCATION: (Show sketch of the location below)

Nearest Town: \_\_\_\_\_ County: AVERY

OFF RHONEY VIEW OFF HWY 19E

(Road, Community, or Subdivision and Lot No.)

2.

DEPTH		DRILLING LOG
From	To	Formation Description
0	80	DIRT
80	320	GRANITE, LIMESTONE
320	323	QUARTZ
323	365	GRANITE

3. DATE DRILLED 11/22/99 USE OF WELL PVT

4. TOTAL DEPTH 365'

5. CUTTINGS COLLECTED YES  NO

6. DOES WELL REPLACE EXISTING WELL? YES  NO

7. STATIC WATER LEVEL Below Top of Casing: 60 FT.

(Use "+" if Above Top of Casing)

8. TOP OF CASING IS 1 FT. Above Land Surface\*

\* Casing Terminated at/or below land surface is illegal unless a variance is issued in accordance with 15A NCAC 2C .0118

9. YIELD (gpm): 10 METHOD OF TEST AIR

10. WATER ZONES (depth): 10 gpm 320-323'

11. CHLORINATION: Type HTH Amount 64 tabs

If additional space is needed use back of form

12. CASING:

LOCATION SKETCH

(Show direction and distance from at least two State Roads, or other map reference points)

Depth	Diameter	Wall Thickness or Weight/Ft	Material
From _____ To _____ Ft.	_____	_____	_____
From <u>0</u> To <u>84</u> Ft.	<u>6 1/4</u>	<u>0.188</u>	<u>GALV</u>
From _____ To _____ Ft.	_____	_____	_____

13. GROUT:

Depth	Material	Method
From <u>0</u> To <u>20</u> Ft.	<u>CEMENT</u>	<u>PUMPED</u>
From _____ To _____ Ft.	_____	_____


14. SCREEN:

Depth	Diameter	Slot Size	Material
From _____ To _____ Ft.	_____ in.	_____ in.	_____
From _____ To _____ Ft.	_____ in.	_____ in.	_____
From _____ To _____ Ft.	_____ in.	_____ in.	_____

15. SAND/GRAVEL PACK:

Depth	Size	Material
From _____ To _____ Ft.	_____	_____
From _____ To _____ Ft.	_____	_____

16. REMARKS:

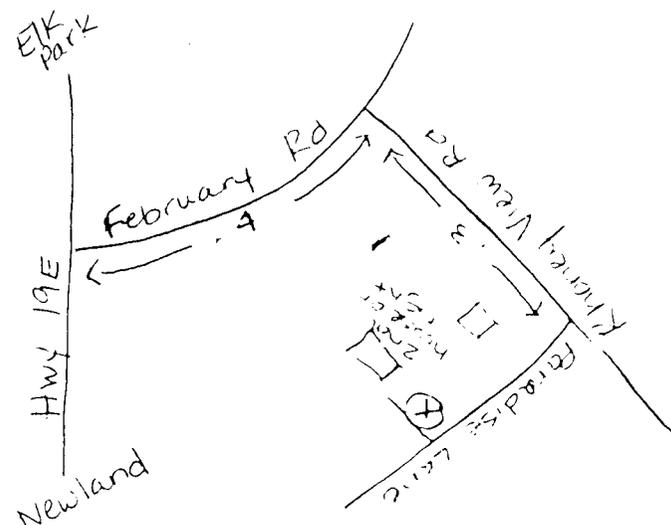

I DO HEREBY CERTIFY THAT THIS WELL WAS CONSTRUCTED IN ACCORDANCE WITH 15A NCAC 2C, WELL CONSTRUCTION STANDARDS, AND THAT A COPY OF THIS RECORD HAS BEEN PROVIDED TO THE WELL OWNER

JAN 31 2000

*Ang Greene*

1-26-00

SIGNATURE OF CONTRACTOR OR AGENT

DATE

Submit original to Division of Environmental Management and copy to well owner

