

99 839

FOR OFFICE USE ONLY 206532

QUAD. NO. _____ SERIAL NO. _____
 Lat. _____ Long. _____ Pc _____
 Minor Basin _____
 Basin Code _____
 Header Ent. _____ GW-1 Ent. _____

WELL CONSTRUCTION RECORD

DRILLING CONTRACTOR: Dewey Wright Well & Pump Co. Inc.
 DRILLER REGISTRATION NUMBER: 266 STATE WELL CONSTRUCTION PERMIT NUMBER: Steve Petty

1. WELL LOCATION: (Show sketch of the location below)
 Nearest Town: Crossnore County: AVERY
SR#1114 OFF LICK LOG RD#1121
 (Road, Community, or Subdivision and Lot No.)

2. _____
 3. DATE DRILLED 11/29/99 USE OF WELL PVT
 4. TOTAL DEPTH 305'
 5. CUTTINGS COLLECTED YES NO
 6. DOES WELL REPLACE EXISTING WELL? YES NO
 7. STATIC WATER LEVEL Below Top of Casing: 30 FT.
 (Use "+" if Above Top of Casing)
 8. TOP OF CASING IS 1 FT. Above Land Surface*
 * Casing Terminated at/or below land surface is illegal unless a variance is issued
 In accordance with 15A NCAC 2C .0118
 9. YIELD (gpm): _____ METHOD OF TEST AIR
 10. WATER ZONES (depth): 1 gpm 115-116' 2 gpm 240-241'

DEPTH		DRILLING LOG Formation Description
From	To	
0	37	DIRT
37	115	GRANITE
115	116	SHALE
116	240	GRANITE
240	241	QUARTZ
241	305	GRANITE

00 FEB -8 AM 11:00
 DRILLER/OWNER SECTION

11. CHLORINATION: Type HTH Amount 56 tabs If additional space is needed use back of form
 12. CASING:

Depth	Diameter	Wall Thickness or Weight/Ft.	Material
From <u>0</u> To <u>42</u> Ft.	<u>6 1/4</u>	<u>0.188</u>	<u>GALV</u>
From _____ To _____ Ft.	_____	_____	_____

13. GROUT:

Depth	Material	Method
From <u>0</u> To <u>20</u> Ft.	<u>CEMENT</u>	<u>PUMPED</u>
From _____ To _____ Ft.	_____	_____



14. SCREEN:

Depth	Diameter	Slot Size	Material
From _____ To _____ Ft.	_____ in.	_____ in.	_____
From _____ To _____ Ft.	_____ in.	_____ in.	_____
From _____ To _____ Ft.	_____ in.	_____ in.	_____

15. SAND/GRAVEL PACK:

Depth	Size	Material
From _____ To _____ Ft.	_____	_____
From _____ To _____ Ft.	_____	_____

16. REMARKS:

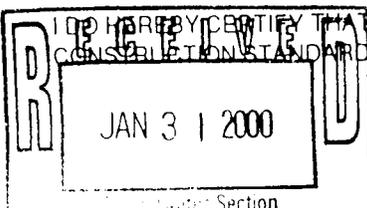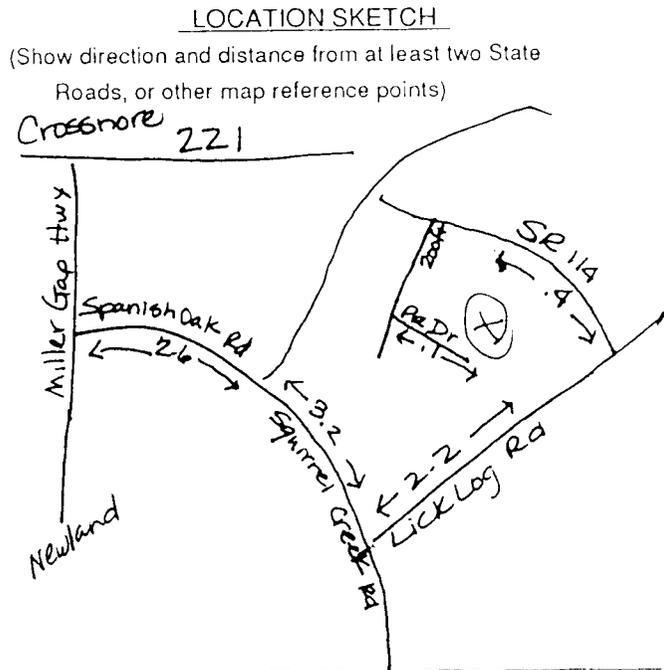

Angi Greene
 SIGNATURE OF CONTRACTOR OR AGENT

1.26.00
 DATE