

99 586

FOR OFFICE USE ONLY		206534
QUAD. NO.	SERIAL NO.	
Lat.	Long.	Pc.
Minor Basin		
Basin Code		
Header Ent.	GW-1 Ent.	

WELL CONSTRUCTION RECORD

DRILLING CONTRACTOR: Dewey Wright Well & Pump Co. Inc. STATE WELL CONSTRUCTION
 DRILLER REGISTRATION NUMBER: 266 PERMIT NUMBER: Steve Reece

1. WELL LOCATION: (Show sketch of the location below)

Nearest Town: Banner Elk County: AVERY

MOUNTAIN MEADOW OFF HICKORY NUT GAP #1342

(Road, Community or Subdivision and Lot No.)

DEPTH DRILLING LOG
 From To Formation Description

2.

0	25	DIRT
25	300	GRANITE
300	302	QUARTZ
302	570	GRANITE
570	573	QUARTZ
573	605	GRANITE

3. DATE DRILLED 11/26/99 USE OF WELL PVT

4. TOTAL DEPTH 605'

5. CUTTINGS COLLECTED YES NO

6. DOES WELL REPLACE EXISTING WELL? YES NO

7. STATIC WATER LEVEL Below Top of Casing: 300 FT.
 (Use "+" if Above Top of Casing)

8. TOP OF CASING IS 1 FT. Above Land Surface*

* Casing Terminated at/or below land surface is illegal unless a variance is issued in accordance with 15A NCAC 2C .0118

9. YIELD (gpm): 6 METHOD OF TEST AIR

10. WATER ZONES (depth): .5 gpm 300-302' 5.5 gpm 570-573'

11. CHLORINATION: Type HTH Amount 64 tabs

12. CASING:

From	To	Depth	Diameter	Wall Thickness or Weight/Ft.	Material	
From	To	0	28	6 1/4	0.188	GALV

13. GROUT:

From	To	Depth	Material	Method	
From	To	0	20	CEMENT	PUMPED


14. SCREEN:

From	To	Depth	Diameter	Slot Size	Material
From	To				

15. SAND/GRAVEL PACK:

From	To	Depth	Size	Material
From	To			

16. REMARKS:

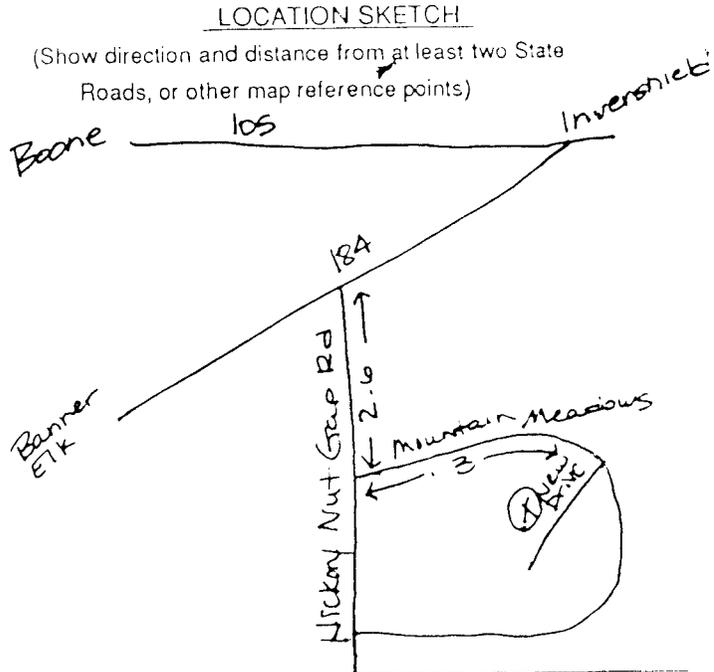

DIVISION OF ENVIRONMENTAL MANAGEMENT
 GROUNDWATER SECTION
 00 FEB - 9 AM 11:08

RECEIVED
 JAN 31 2000
 Groundwater Section

DO HEREBY CERTIFY THAT THIS WELL WAS CONSTRUCTED IN ACCORDANCE WITH 15A NCAC 2C, WELL CONSTRUCTION STANDARDS, AND THAT A COPY OF THIS RECORD HAS BEEN PROVIDED TO THE WELL OWNER.

SIGNATURE OF CONTRACTOR OR AGENT: Ang Greene DATE: 1.26.00