

99903

FOR OFFICE USE ONLY SERIAL NO. **206925**

QUAD. NO. _____ SERIAL NO. _____
 Lat. _____ Long. _____ Pc _____
 Minor Basin _____
 Basin Code _____
 Header Ent. _____ GW-1 Ent. _____

WELL CONSTRUCTION RECORD

DRILLING CONTRACTOR: Dewey Wright Well & Pump Co. INC STATE WELL CONSTRUCTION
 DRILLER REGISTRATION NUMBER: 266 PERMIT NUMBER: S. Reece

1. WELL LOCATION: (Show sketch of the location below)
 Nearest Town: BANNER ELK County: AVERY
FLAT SPRINGS RD 1.1 MILE FROM HWY 321 N.
 (Road, Community, or Subdivision and Lot No.)

DEPTH		DRILLING LOG
From	To	Formation Description
0	38	DIRT
38	70	GRANITE, QUARTZ
70	73	SHALE
73	265	GRANITE


2. DATE DRILLED 12/09/99 USE OF WELL PVT
 3. TOTAL DEPTH 265'
 4. CUTTINGS COLLECTED YES NO
 5. DOES WELL REPLACE EXISTING WELL? YES NO
 6. STATIC WATER LEVEL Below Top of Casing: 60 FT.
 (Use "+" if Above Top of Casing)
 7. TOP OF CASING IS 1 FT. Above Land Surface*
 * Casing Terminated at/or below land surface is illegal unless a variance is issued
 In accordance with 15A NCAC 2C .0118
 8. YIELD (gpm): 2 METHOD OF TEST AIR
 9. WATER ZONES (depth): 2 gpm 70-73'
 10. CHLORINATION: Type HTH Amount 43 tabs If additional space is needed use back of form
 11. CASING:

Depth	Diameter	Wall Thickness or Weight/Ft.	Material
From <u>0</u> To <u>42</u> Ft.	<u>6 1/4</u>	<u>0.188</u>	<u>GALV</u>

Depth	Material	Method
From <u>0</u> To <u>20</u> Ft.	<u>CEMENT</u>	<u>PUMPED</u>


Depth	Diameter	Slot Size	Material
From _____ To _____ Ft.	_____ in.	_____ in.	_____

Depth	Size	Material
From _____ To _____ Ft.	_____	_____

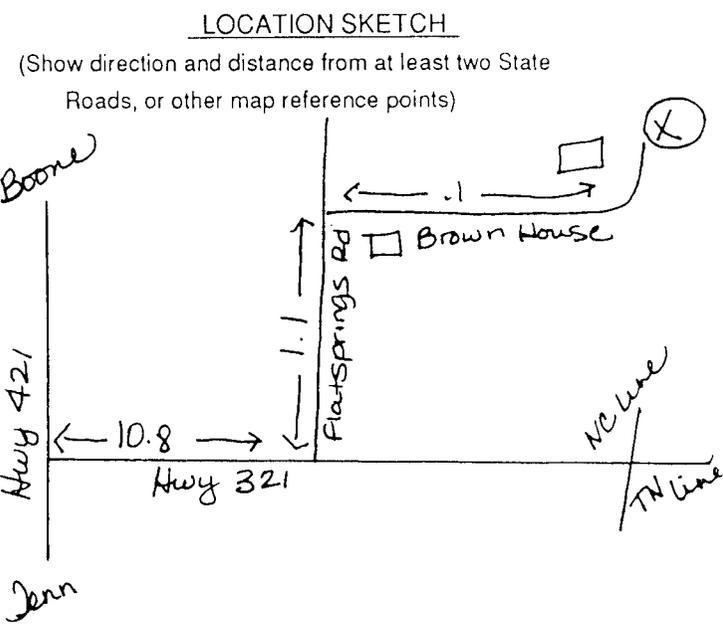

RECEIVED
 DIVISION OF ENVIRONMENTAL MANAGEMENT
 FEB 22 AM 9:11

I DO HEREBY CERTIFY THAT THIS WELL WAS CONSTRUCTED IN ACCORDANCE WITH 15A NCAC 2C, WELL CONSTRUCTION STANDARDS, AND THAT A COPY OF THIS RECORD HAS BEEN PROVIDED TO THE WELL OWNER.

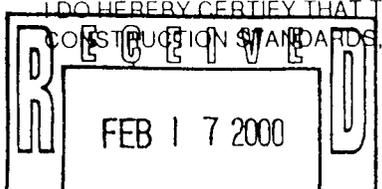

Greene 2.15.00
 SIGNATURE OF CONTRACTOR OR AGENT DATE
 Submit original to Division of Environmental Management and copy to well owner.