

99827

FOR OFFICE USE ONLY		206927
QUAD. NO. _____	SERIAL NO. _____	
Lat. _____	Long. _____	Pc. _____
Minor Basin _____		
Basin Code _____		
Header Ent. _____		GW-1 Ent

WELL CONSTRUCTION RECORD

DRILLING CONTRACTOR: Dewey Wright Well & Pump Co., Inc. STATE WELL CONSTRUCTION
 DRILLER REGISTRATION NUMBER: 266 PERMIT NUMBER: S. Reece

1. WELL LOCATION: (Show sketch of the location below)

Nearest Town: BOONE County: AVERY

OFF RUSS NORRIS RD. OFF BUCKEYE RD. OFF

(Road, Community, or Subdivision and Lot No.)

DEPTH		DRILLING LOG
From	To	Formation Description
0	57	DIRT
57	90	GRANITE
90	94	SHALE
94	245	GRANITE

3. DATE DRILLED 12/16/99 USE OF WELL PVT
4. TOTAL DEPTH 245'
5. CUTTINGS COLLECTED YES NO
6. DOES WELL REPLACE EXISTING WELL? YES NO
7. STATIC WATER LEVEL Below Top of Casing: 40 FT.
 (Use "+" if Above Top of Casing)
8. TOP OF CASING IS 1 FT. Above Land Surface*
- * Casing Terminated at/or below land surface is illegal unless a variance is issued in accordance with 15A NCAC 2C .0118
9. YIELD (gpm): 2 METHOD OF TEST AIR
10. WATER ZONES (depth): 2 gpm 90-94'


DRILLING LOG SECTION
 DATE FEB 22 AM 9:11

11. CHLORINATION: Type HTH Amount 43 tabs If additional space is needed use back of form

12. CASING:

Depth	Diameter	Wall Thickness or Weight/Ft.	Material
From <u>0</u> To <u>63</u> Ft.	<u>6 1/4</u>	<u>0.188</u>	<u>GALV.</u>
From _____ To _____ Ft.	_____	_____	_____
From _____ To _____ Ft.	_____	_____	_____

LOCATION SKETCH

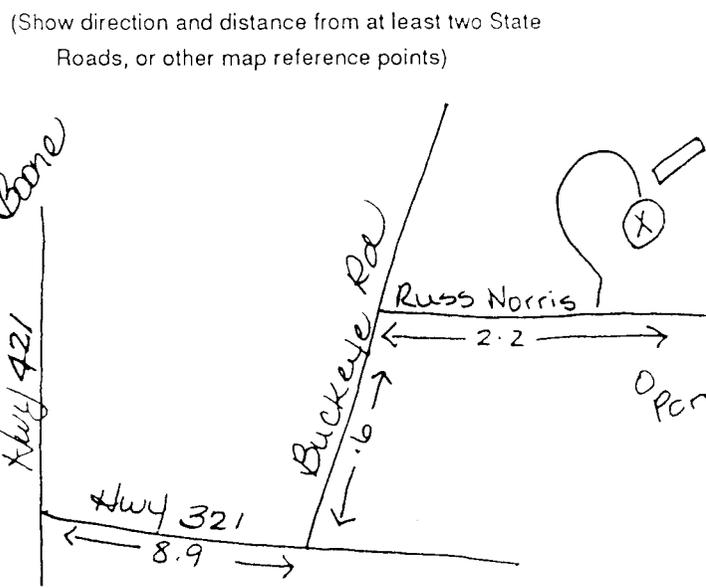

13. GROUT:

Depth	Material	Method
From <u>0</u> To <u>20</u> Ft.	<u>CEMENT</u>	<u>PUMPED</u>
From _____ To _____ Ft.	_____	_____


14. SCREEN:

Depth	Diameter	Slot Size	Material
From _____ To _____ Ft.	_____ in.	_____ in.	_____
From _____ To _____ Ft.	_____ in.	_____ in.	_____
From _____ To _____ Ft.	_____ in.	_____ in.	_____

15. SAND/GRAVEL PACK:

Depth	Size	Material
From _____ To _____ Ft.	_____	_____
From _____ To _____ Ft.	_____	_____

16. REMARKS:

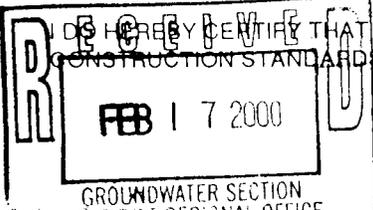

A Greene 2-15-00

SIGNATURE OF CONTRACTOR OR AGENT DATE

Submit original to Division of Environmental Management and copy to well owner.