

99 898

FOR OFFICE USE ONLY
 QUAD. NO. _____ SERIAL NO. 206930
 Lat _____ Long _____ Pc _____
 Minor Basin _____
 Basin Code _____
 Header Ent. _____ GW-1 Ent. _____

WELL CONSTRUCTION RECORD

DRILLING CONTRACTOR: Dewey Wright Well & Pump Co. Inc.
 DRILLER REGISTRATION NUMBER: 266 STATE WELL CONSTRUCTION PERMIT NUMBER: S. Reece

1. WELL LOCATION: (Show sketch of the location below)
 Nearest Town: NEWLAND County: AVERY
OFF RHONEY VIEW OFF FEBRUARY OFF 19E

(Road, Community, or Subdivision and Lot No.)

2. DATE DRILLED 12/14/99 USE OF WELL PVT
 4. TOTAL DEPTH 205'
 5. CUTTINGS COLLECTED YES NO
 6. DOES WELL REPLACE EXISTING WELL? YES NO
 7. STATIC WATER LEVEL Below Top of Casing: 60 FT.
 (Use "+" if Above Top of Casing)


DEPTH		DRILLING LOG
From	To	Formation Description
0	79	DIRT
79	120	GRANITE
120	122	SHALE
122	205	GRANITE

8. TOP OF CASING IS 1 FT. Above Land Surface*
 * Casing Terminated at or below land surface is illegal unless a variance is issued
 In accordance with 15A NCAC 2C .0118 AIR
 9. YIELD (gpm): 20 METHOD OF TEST _____
 10. WATER ZONES (depth): 20 gpm 120-122'

11. CHLORINATION: Type HTH Amount 30 tabs If additional space is needed use back of form
 12. CASING:

From	To	Depth	Diameter	Wall Thickness or Weight/Ft.	Material
0	86	Ft.	6 1/4	0.188	GALV.

LOCATION SKETCH
 (Show direction and distance from at least two State Roads, or other map reference points)

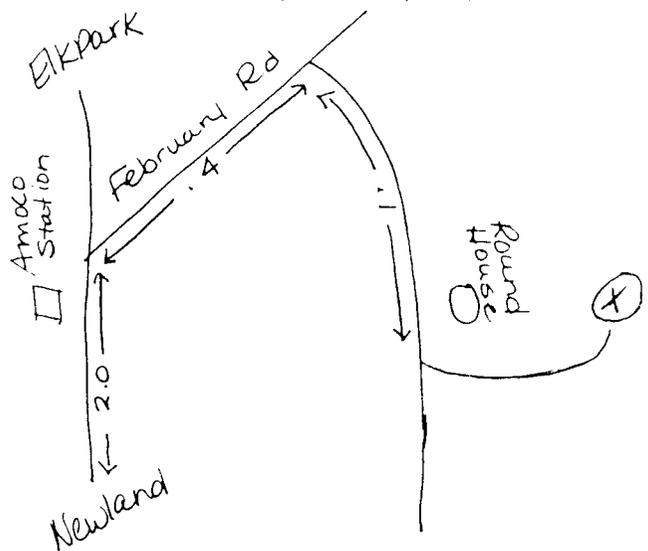


13. GROUT:
 From 0 To 20 Ft. Material CEMENT Method PUMPED

14. SCREEN:
 From _____ To _____ Ft. Diameter _____ Slot Size _____ Material _____

15. SAND/GRAVEL PACK:
 From _____ To _____ Ft. Size _____ Material _____

16. REMARKS _____

I DO HEREBY CERTIFY THAT THIS WELL WAS CONSTRUCTED IN ACCORDANCE WITH 15A NCAC 2C, WELL CONSTRUCTION STANDARDS, AND THAT A COPY OF THIS RECORD HAS BEEN PROVIDED TO THE WELL OWNER.

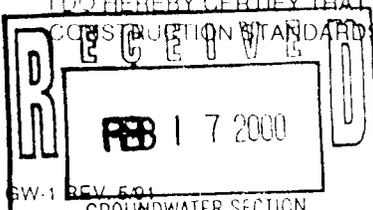

S. Reece
 SIGNATURE OF CONTRACTOR OR AGENT
 DATE Feb 15, 2000
 Submit original to Division of Environmental Management and copy to well owner.