

99 823

FOR OFFICE USE ONLY 207596

QUAD. NO. _____ SERIAL NO. _____

Lat. _____ Long. _____ Pc. _____

Minor Basin _____

Basin Code _____

Header Ent. _____ GW-1 Ent. _____

WELL CONSTRUCTION RECORD

DRILLING CONTRACTOR: Dewey Wright Well & Pump Co. Inc. STATE WELL CONSTRUCTION

DRILLER REGISTRATION NUMBER: 2681 PERMIT NUMBER: _____

1. WELL LOCATION: (Show sketch of the location below)

Nearest Town: BANNER ELK County: AVERY

CURTIS CREEK OF HWY 194

(Road, Community, or Subdivision and Lot No.)


2. _____
3. DATE DRILLED 01/24/00 USE OF WELL PVT
4. TOTAL DEPTH 125'
5. CUTTINGS COLLECTED YES NO
6. DOES WELL REPLACE EXISTING WELL? YES NO
7. STATIC WATER LEVEL Below Top of Casing: 20 FT.
 (Use "+" if Above Top of Casing)
8. TOP OF CASING IS 1 FT. Above Land Surface*
- * Casing Terminated at/or below land surface is illegal unless a variance is issued in accordance with 15A NCAC 2C .0118
9. YIELD (gpm): 10 METHOD OF TEST AIR
10. WATER ZONES (depth): 6 gpm 91-92' 4 gpm 115-116'

DEPTH		DRILLING LOG
From	To	Formation Description
0	58	DIRT
58	91	GRANITE
91	92	SHALE
92	115	GRANITE
115	116	SHALE
116	125	GRANITE

OD MAR - 8 PM 1:09
 DIVISION OF ENVIRONMENTAL MANAGEMENT

11. CHLORINATION: Type HTH Amount 29 tabs If additional space is needed use back of form
12. CASING:

LOCATION SKETCH

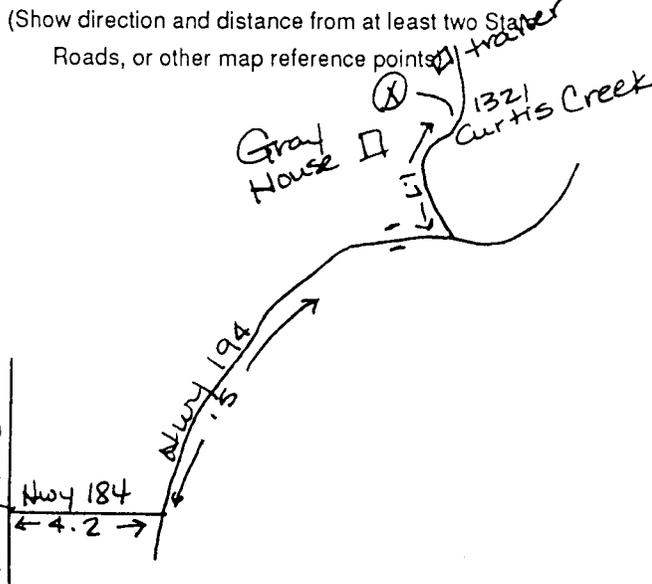

13. GROUT:
- | Depth | Material | Method |
|--------------------------------|---------------|---------------|
| From <u>0</u> To <u>20</u> Ft. | <u>CEMENT</u> | <u>PUMPED</u> |
14. SCREEN:
- | Depth | Diameter | Slot Size | Material |
|-------------------------|-----------|-----------|----------|
| From _____ To _____ Ft. | _____ in. | _____ in. | _____ |
15. SAND/GRAVEL PACK:
- | Depth | Size | Material |
|-------------------------|-------|----------|
| From _____ To _____ Ft. | _____ | _____ |

16. REMARKS:

I DO HEREBY CERTIFY THAT THIS WELL WAS CONSTRUCTED IN ACCORDANCE WITH 15A NCAC 2C, WELL CONSTRUCTION STANDARDS, AND THAT A COPY OF THIS RECORD HAS BEEN PROVIDED TO THE WELL OWNER.

Steve Petty

Steve S. Petty

Feb 28, 2000

SIGNATURE OF CONTRACTOR OR AGENT DATE

Submit original to Division of Environmental Management and copy to well owner