

00 37

FOR OFFICE USE ONLY
 QUAD. NO. _____ SERIAL NO. **208499**
 Lat. _____ Long. _____ Pc _____
 Minor Basin _____
 Basin Code _____
 Header Ent. _____ GW-1 Ent. _____

WELL CONSTRUCTION RECORD

DRILLING CONTRACTOR: Dewey Wright Well & Pump Co., Inc.

STATE WELL CONSTRUCTION PERMIT NUMBER: _____

DRILLER REGISTRATION NUMBER: 2681

1. WELL LOCATION: (Show sketch of the location below)

Nearest Town: SPRUCE PINE County: AVERY

OFF OLD 19E OFF HWY 19E

(Road, Community, or Subdivision and Lot No.)

2.

DEPTH DRILLING LOG
 From To Formation Description

0	37	DIRT
37	87	GRANITE
87	88	SHALE
88	210	GRANITE
210	211	QUARTZ
211	360	GRANITE
360	361	SHALE
361	385	GRANITE

3. DATE DRILLED 02/11/00 USE OF WELL PVT
 4. TOTAL DEPTH 385'
 5. CUTTINGS COLLECTED YES NO
 6. DOES WELL REPLACE EXISTING WELL? YES NO
 7. STATIC WATER LEVEL Below Top of Casing: 20 FT.

8. TOP OF CASING IS 1 FT. Above Land Surface*

* Casing Terminated at/or below land surface is illegal unless a variance is issued in accordance with 15A NCAC 2C .0118

9. YIELD (gpm): 12 METHOD OF TEST AIR

10. WATER ZONES (depth): 1/2 gpm 87-88' 1/2 gpm 210-211'
11 gpm 360-361'

11. CHLORINATION: Type HTH Amount 73 tabs If additional space is needed use back of form

12. CASING:

LOCATION SKETCH

(Show direction and distance from at least two State Roads, or other map reference points)

Depth	Diameter	Wall Thickness or Weight/Ft.	Material
From <u>0</u> To <u>42</u> Ft.	<u>6 1/4</u>	<u>0.188</u>	<u>GALV.</u>
From _____ To _____ Ft.	_____	_____	_____

13. GROUT:

Depth	Material	Method
From <u>0</u> To <u>20</u> Ft.	<u>CEMENT</u>	<u>Gravity Flow</u>
From _____ To _____ Ft.	_____	_____


14. SCREEN:

Depth	Diameter	Slot Size	Material
From _____ To _____ Ft.	_____ in.	_____ in.	_____
From _____ To _____ Ft.	_____ in.	_____ in.	_____
From _____ To _____ Ft.	_____ in.	_____ in.	_____

15. SAND/GRAVEL PACK:

Depth	Material
From _____ To _____	_____
From _____ To _____	_____

16. REMARKS:

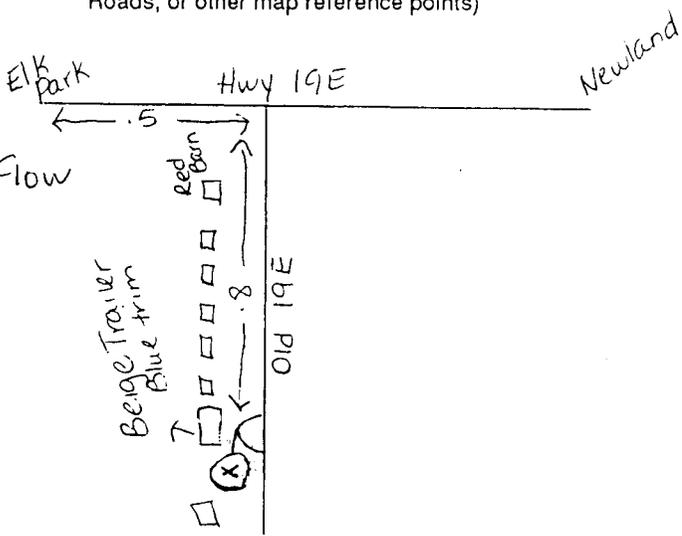

I DO HEREBY CERTIFY THAT THIS WELL WAS CONSTRUCTED IN ACCORDANCE WITH 15A NCAC 2C, WELL CONSTRUCTION STANDARDS, AND THAT A COPY OF THIS RECORD HAS BEEN PROVIDED TO THE WELL OWNER.

APR - 5 2000

Steve Petty
 Signature of Contractor or Agent

3-31-00
 DATE