

211402

WELL CONSTRUCTION RECORD

WELL CONTRACTOR: _____
 WELL CONTRACTOR CERTIFICATION #: 2388
 STATE WELL CONSTRUCTION PERMIT#: _____

1. WELL USE (Check Applicable Box): Residential Municipal Industrial Agricultural Monitoring
 Recovery Heat Pump Water Injection Other If Other, List Use: _____

2. WELL LOCATION: (Show sketch of the location below)
 Nearest Town: Fruenshield County: Avery

3. _____
 4. DATE DRILLED 5-25-00
 5. TOTAL DEPTH 280
 6. CUTTINGS COLLECTED YES NO
 7. DOES WELL REPLACE EXISTING WELL? YES NO
 8. STATIC WATER LEVEL Below Top of Casing: 60 FT.
 (Use "+" if Above Top of Casing)
 9. TOP OF CASING IS 1 FT. Above Land Surface*

DRILLING LOG		DEPTH
From	To	Formation Description
25	39	shalerock brecciated
39	63	granite
63	68	shalerock
68	76	granite shalerock
76	82	shalerock
82	255	granite
255	257	cracks granite
257	280	granite

*Top of casing terminated at/or below land surface requires a variance in accordance with 15A NCAC 2C .0118
 10. YIELD (gpm): 100 METHOD OF TEST Air
 11. WATER ZONES (depth): 255-257 100gpm

12. CHLORINATION: Type HTH Amount _____
 13. CASING: 48ft

If additional space is needed use back of form

From	To	Depth	Diameter	Wall Thickness or Weight/Ft.	Material
-1	44	44	6 5/8	2.0R21	PVC
44	47	47	6 3/4	1.88	Galv


14. GROUT:
 Depth Material Method
 From _____ To _____ Ft. _____
 From _____ To _____ Ft. _____

15. SCREEN:
 Depth Diameter Slot Size Material
 From _____ To _____ Ft. _____ in. _____ in. _____
 From _____ To _____ Ft. _____ in. _____ in. _____
 From _____ To _____ Ft. _____ in. _____ in. _____

16. SAND/GRAVEL PACK:
 Depth Size Material
 From _____ To _____ Ft. _____
 From _____ To _____ Ft. _____

17. REMARKS: Magneted too fine well too eighty five feet

LOCATION SKETCH
 (Show direction and distance from at least two State Roads, or other map reference points)

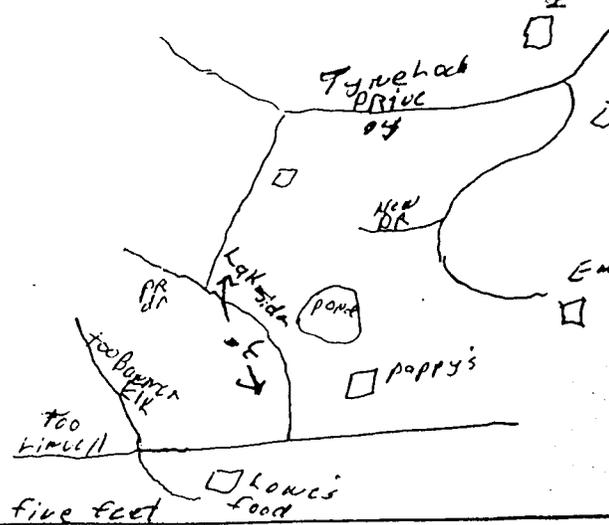

RECEIVED A DENR DIVISION OF GROUNDWATER SECTION 00 JUN -5 PM 2:56

I DO HEREBY CERTIFY THAT THIS WELL WAS CONSTRUCTED IN ACCORDANCE WITH 15A NCAC 2C, WELL CONSTRUCTION STANDARDS, AND THAT A COPY OF THIS RECORD HAS BEEN PROVIDED TO THE WELL OWNER.

Chad E. Brunell
 SIGNATURE OF PERSON CONSTRUCTING THE WELL

5-25-2000
 DATE

FOR OFFICE USE ONLY
 Quad No: _____
 Serial No. _____

RECEIVED
 MAY 31 2000
 Groundwater Section
 Asheville Regional Office

RECEIVED
 Groundwater Section
 Asheville Regional Office

211402