

WELL CONSTRUCTION RECORD

WELL CONTRACTOR: Dewey Wright Well Pump Co., Inc.  
WELL CONTRACTOR CERTIFICATION #: 2687  
STATE WELL CONSTRUCTION PERMIT#: Steve Reece

000252

1. WELL USE (Check Applicable Box): Residential  Municipal  Industrial  Agricultural  Monitoring   
Recovery  Heat Pump Water Injection  Other  If Other, List Use: \_\_\_\_\_

2. WELL LOCATION: (Show sketch of the location below)  
Nearest Town: ELK PARK County: AVERY  
JERRY CREEK RD OFF ROARING CRK RD. OFF OLD 1  
(Road Name and Numbers, Community, or Subdivision and Lot No.)

3. \_\_\_\_\_  
4. DATE DRILLED 5/22/2000  
5. TOTAL DEPTH 125  
6. CUTTINGS COLLECTED YES  NO   
7. DOES WELL REPLACE EXISTING WELL? YES  NO   
8. STATIC WATER LEVEL Below Top of Casing: 60 FT.  
(Use "+" if Above Top of Casing)

9. TOP OF CASING IS 1 FT. Above Land Surface\*  
\*Top of casing terminated at/or below land surface requires a variance in accordance with 15A NCAC 2C.0118  
10. YIELD (gpm): 30 METHOD OF TEST Air  
11. WATER ZONES (depth) 30 gpm 100-103 0 gpm  
0 gpm 0 gpm  
12. CHLORINATION: Type HTH Amount 13


DRILLING LOG		DEPTH	Formation Description
From	To		
0	80		DIRT
80	100		GRANITE
100	103		SHALE
103	125		GRANITE

RECEIVED / DENR  
DWD GROUNDWATER SECTION  
00 JUN 19 PM 2:00

If additional space is needed use back of form

13. CASING:  
Depth Diameter Wall Thickness or Weight/Ft. Material  
From 0 To 85 Ft. 6 1/8 350 PVC  
From \_\_\_\_\_ To \_\_\_\_\_ Ft. \_\_\_\_\_ \_\_\_\_\_  
From \_\_\_\_\_ To \_\_\_\_\_ Ft. \_\_\_\_\_ \_\_\_\_\_

LOCATION SKETCH  
(Show direction and distance from at least two State Roads, or other map reference points)

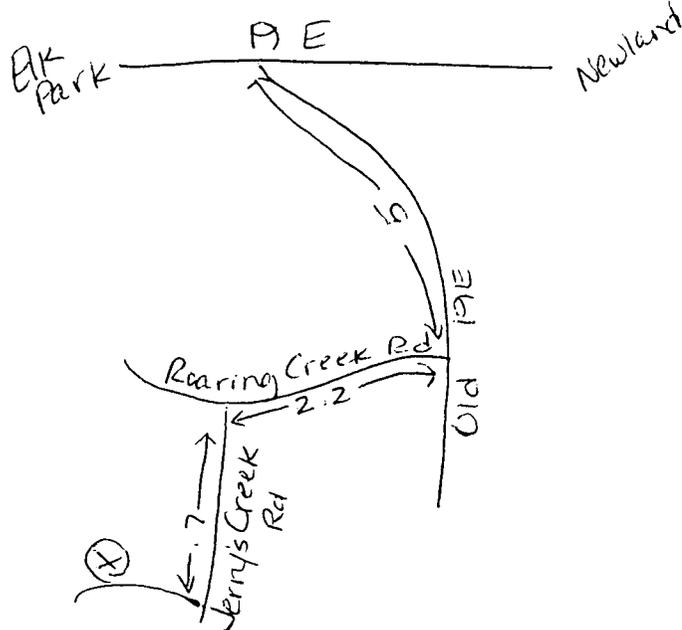

14. GROUT:  
Depth Material Method  
From 0 To 20 Ft. Cement Gravity Flow  
From \_\_\_\_\_ To \_\_\_\_\_ Ft. \_\_\_\_\_ \_\_\_\_\_

15. SCREEN:  
Depth Diameter Slot Size Material  
From \_\_\_\_\_ To \_\_\_\_\_ Ft. \_\_\_\_\_ in. \_\_\_\_\_ in. \_\_\_\_\_  
From \_\_\_\_\_ To \_\_\_\_\_ Ft. \_\_\_\_\_ in. \_\_\_\_\_ in. \_\_\_\_\_  
From \_\_\_\_\_ To \_\_\_\_\_ Ft. \_\_\_\_\_ in. \_\_\_\_\_ in. \_\_\_\_\_

16. SAND/GRAVEL PACK:  
Depth Size Material  
From \_\_\_\_\_ To \_\_\_\_\_ Ft. \_\_\_\_\_ \_\_\_\_\_  
From \_\_\_\_\_ To \_\_\_\_\_ Ft. \_\_\_\_\_ \_\_\_\_\_

17. REMARKS:  
I DO HEREBY CERTIFY THAT THIS WELL WAS CONSTRUCTED IN ACCORDANCE WITH 15A NCAC 2C, WELL CONSTRUCTION STANDARDS, AND THAT A COPY OF THIS RECORD HAS BEEN PROVIDED TO THE WELL OWNER.

Signature: Steve Reece 6-12-00  
SIGNATURE OF PERSON CONSTRUCTING THE WELL DATE

FOR OFFICE USE ONLY  
Quad No: \_\_\_\_\_  
Serial No. \_\_\_\_\_