

**WELL CONSTRUCTION RECORD**

WELL CONTRACTOR: Dewey Wright Well Pump Co., Inc.  
 WELL CONTRACTOR CERTIFICATION #: 2687  
 STATE WELL CONSTRUCTION PERMIT#: Steve Reece

000298

1. WELL USE (Check Applicable Box): Residential  Municipal  Industrial  Agricultural  Monitoring   
 Recovery  Heat Pump Water Injection  Other  If Other, List Use: \_\_\_\_\_

2. WELL LOCATION: (Show sketch of the location below)  
 Nearest Town: BANNER FLK County: AVERY  
OFF TAMARACK LANE OFF HWY 184  
(Road Name and Numbers, Community, or Subdivision and Lot No.)

3. \_\_\_\_\_  
 4. DATE DRILLED 5/23/2000  
 5. TOTAL DEPTH 165  
 6. CUTTINGS COLLECTED YES  NO   
 7. DOES WELL REPLACE EXISTING WELL? YES  NO   
 8. STATIC WATER LEVEL Below Top of Casing: 10 FT.  
(Use "+" if Above Top of Casing)

DRILLING LOG		DEPTH
From	To	Formation Description
0	19	DIRT/ROCK
19	30	GRANITE
30	32	SHALE
32	140	GRANITE
140	142	SHALE
142	165	GRANITE

If additional space is needed use back of form

9. TOP OF CASING IS 1 FT. Above Land Surface\*  
\*Top of casing terminated at/or below land surface requires a variance in accordance with 15A NCAC 2C.0118  
 10. YIELD (gpm): 20 METHOD OF TEST Air  
 11. WATER ZONES (depth) 2 gpm 30-32 18 gpm 140-142  
0 gpm 0 gpm  
 12. CHLORINATION: Type HTH Amount 32

RECEIVED / DENR  
 DIV. OF GROUNDWATER SECTION  
 JUN 19 PM 2:00


13. CASING:  

Depth	Diameter	Wall Thickness or Weight/Ft.	Material
From <u>0</u> To <u>25</u> Ft.	<u>6 1/4</u>	<u>188</u>	<u>GALV</u>
From _____ To _____ Ft.	_____	_____	_____
From _____ To _____ Ft.	_____	_____	_____

LOCATION SKETCH  
 (Show direction and distance from at least two State Roads, or other map reference points)

14. GROUT:  

Depth	Material	Method
From <u>0</u> To <u>20</u> Ft.	<u>Cement</u>	<u>Gravity Flow</u>
From _____ To _____ Ft.	_____	_____

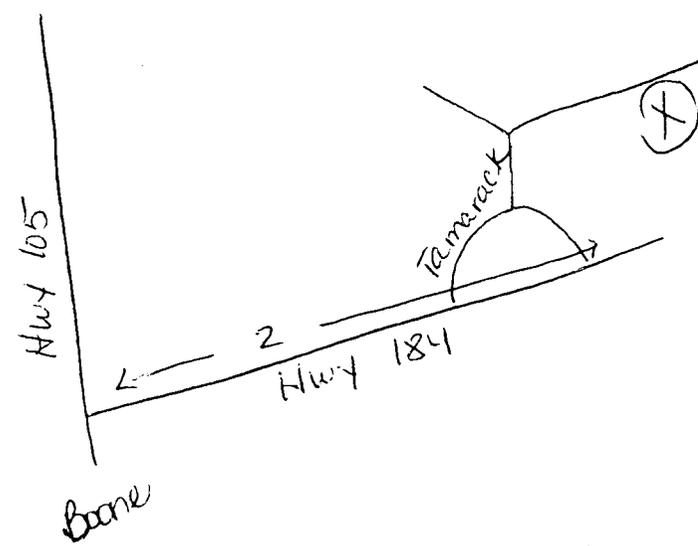

15. SCREEN:  

Depth	Diameter	Slot Size	Material
From _____ To _____ Ft.	_____ in.	_____ in.	_____
From _____ To _____ Ft.	_____ in.	_____ in.	_____
From _____ To _____ Ft.	_____ in.	_____ in.	_____

16. SAND/GRAVEL PACK:  

Depth	Size	Material
From _____ To _____ Ft.	_____	_____
From _____ To _____ Ft.	_____	_____

17. REMARKS: \_\_\_\_\_  
 I DO HEREBY CERTIFY THAT THIS WELL WAS CONSTRUCTED IN ACCORDANCE WITH 15A NCAC 2C, WELL CONSTRUCTION STANDARDS, AND THAT A COPY OF THIS RECORD HAS BEEN PROVIDED TO THE WELL OWNER.

FOR OFFICE USE ONLY  
 Quad No: \_\_\_\_\_  
 Serial No: \_\_\_\_\_

Steve Reece 6-1200  
 SIGNATURE OF PERSON CONSTRUCTING THE WELL DATE  
 Submit original to Division of Water Quality, Groundwater Section within 30 days  
 GW-1 REV. 12/99