

212236

WELL CONSTRUCTION RECORD

000270

WELL CONTRACTOR: Dewey Wright Well Pump Co., Inc.
 WELL CONTRACTOR CERTIFICATION #: 2687
 STATE WELL CONSTRUCTION PERMIT#: Steve Reece

1. WELL USE (Check Applicable Box): Residential Municipal Industrial Agricultural Monitoring
 Recovery Heat Pump Water Injection Other If Other, List Use: _____

2. WELL LOCATION: (Show sketch of the location below)
 Nearest Town: BANNER FLK County: AVERY
ROCK BROOK CT, LOT 242 IN ELK RIVER OFF HWY 184
(Road Name and Numbers, Community, or Subdivision and Lot No.)

DRILLING LOG

From	To	DEPTH	Formation Description
0	60		DIRT
60	90		LIMESTONE
90	93		LIMESTONE
93	110		LIMESTONE
110	113		LIMESTONE
113	170		LIMESTONE
170	173		LIMESTONE
173	205		LIMESTONE

3. DATE DRILLED 5/22/2000
 4. TOTAL DEPTH 205
 5. CUTTINGS COLLECTED YES NO
 6. DOES WELL REPLACE EXISTING WELL? YES NO
 7. STATIC WATER LEVEL Below Top of Casing: 60 FT.
(Use "+" if Above Top of Casing)

8. TOP OF CASING IS 1 FT. Above Land Surface*
*Top of casing terminated at/or below land surface requires a variance in accordance with 15A NCAC 2C.0118
 9. YIELD (gpm): 50 METHOD OF TEST Air
 10. WATER ZONES (depth): 10 gpm 90-93 10 gpm 110-113
30 gpm 170-173 0 gpm
 11. CHLORINATION: Type HTH Amount 30

12. CASING:

Depth	Diameter	Wall Thickness or Weight/Ft.	Material
From <u>0</u> To <u>67</u> Ft.	<u>6 1/8</u>	<u>350</u>	<u>PVC</u>
From _____ To _____ Ft.	_____	_____	_____
From _____ To _____ Ft.	_____	_____	_____

13. GROUT:

Depth	Material	Method
From <u>0</u> To <u>20</u> Ft.	<u>Cement</u>	<u>Gravity Flow</u>
From _____ To _____ Ft.	_____	_____

14. SCREEN:

Depth	Diameter	Slot Size	Material
From _____ To _____ Ft.	_____ in.	_____ in.	_____
From _____ To _____ Ft.	_____ in.	_____ in.	_____
From _____ To _____ Ft.	_____ in.	_____ in.	_____

15. SAND/GRAVEL PACK:

Depth	Size	Material
From _____ To _____ Ft.	_____	_____
From _____ To _____ Ft.	_____	_____


16. REMARKS: I DO HEREBY CERTIFY THAT THIS WELL WAS CONSTRUCTED IN ACCORDANCE WITH 15A NCAC 2C, WELL CONSTRUCTION STANDARDS, AND THAT A COPY OF THIS RECORD HAS BEEN PROVIDED TO THE WELL OWNER.

Steve Reece 6-12-00
 SIGNATURE OF PERSON CONSTRUCTING THE WELL DATE

Submit original to Division of Water Quality, Groundwater Section within 30 days
 GW-1 REV. 12/99

FOR OFFICE USE ONLY
 Quad No: _____

LOCATION SKETCH
 (Show direction and distance from at least two State Roads, or other map reference points)

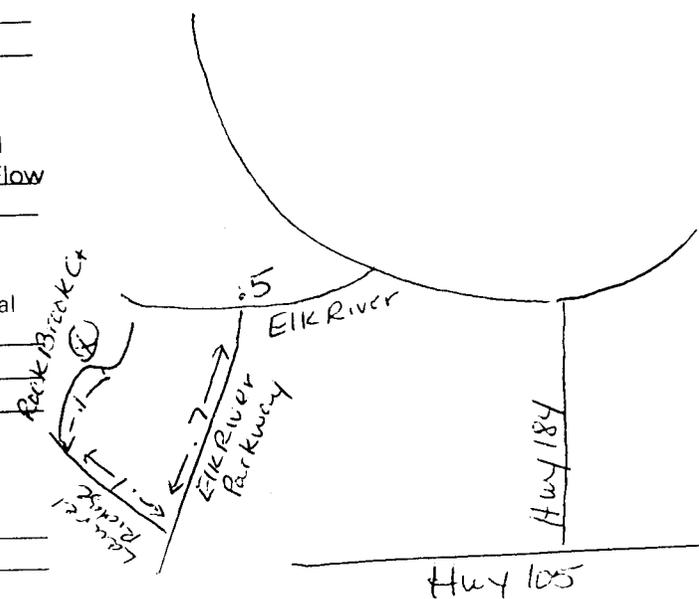

RECEIVED / DENIED / DIVISION OF WATER QUALITY SECTION JUN 19 PM 2:00