

**WELL CONSTRUCTION RECORD**

WELL CONTRACTOR: Dewey Wright Well Pump Co., Inc.  
 WELL CONTRACTOR CERTIFICATION #: 2687  
 STATE WELL CONSTRUCTION PERMIT#: Steve Reece

000314

1. WELL USE (Check Applicable Box): Residential  Municipal  Industrial  Agricultural  Monitoring   
 Recovery  Heat Pump Water Injection  Other  If Other, List Use: \_\_\_\_\_

2. WELL LOCATION: (Show sketch of the location below)  
 Nearest Town: LINVILLE County: AVERY  
HILLSIDE DR. OFF GOLF COURSE RD. OFF CLUBHOUSE  
(Road Name and Numbers, Community, or Subdivision and Lot No.)

3. DATE DRILLED 6/22/2000  
 4. TOTAL DEPTH 405  
 6. CUTTINGS COLLECTED YES  NO   
 7. DOES WELL REPLACE EXISTING WELL? YES  NO   
 8. STATIC WATER LEVEL Below Top of Casing: 40 FT.  
(Use "+" if Above Top of Casing)

DRILLING LOG		DEPTH
From	To	Formation Description
0	58	DIRT
58	70	GRANITE
70	73	SHALE
73	360	GRANITE
360	365	QUARTZ
365	405	GRANITE

RECEIVED  
 DIVISION OF  
 GROUNDWATER  
 SECTION  
 00 JUL 3 PM 9:00

9. TOP OF CASING IS 1 FT. Above Land Surface\*  
\*Top of casing terminated at/or below land surface requires a variance in accordance with 15A NCAC 2C.0118  
 10. YIELD (gpm): 10 METHOD OF TEST Air  
 11. WATER ZONES (depth) 3 gpm 70-73 7 gpm 360-365  
0 gpm 0 gpm  
 12. CHLORINATION: Type HTH Amount 73

13. CASING:

From	To	Depth	Diameter	Wall Thickness or Weight/Ft.	Material
0	63	Ft.	6 1/8	.350	PVC
63	405	Ft.			

14. GROUT:

From	To	Depth	Material	Method
0	20	Ft.	Cement	Gravity Flow
20	405	Ft.		

15. SCREEN:


From	To	Depth	Diameter	Slot Size	Material
		Ft.	in.	in.	

16. SAND/GRAVEL PACK:

From	To	Depth	Size	Material
		Ft.		

17. REMARKS:

**LOCATION SKETCH**  
 (Show direction and distance from at least two State Roads, or other map reference points)

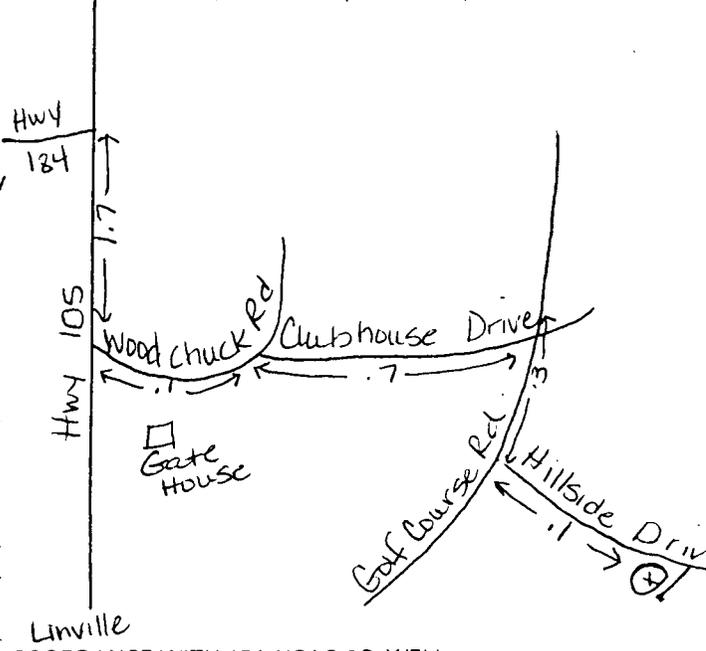

I DO HEREBY CERTIFY THAT THIS WELL WAS CONSTRUCTED IN ACCORDANCE WITH 15A NCAC 2C, WELL CONSTRUCTION STANDARDS, AND THAT A COPY OF THIS RECORD HAS BEEN PROVIDED TO THE WELL OWNER.

Steve Reece 7-6-00  
 SIGNATURE OF PERSON CONSTRUCTING THE WELL DATE

**FOR OFFICE USE ONLY**

Quad No: \_\_\_\_\_

Submit Original to Division of Water Quality, Groundwater Section within 30 days