

WELL CONSTRUCTION RECORD

000366

WELL CONTRACTOR: Dewey Wright Well Pump Co., Inc.
 WELL CONTRACTOR CERTIFICATION #: 2687
 STATE WELL CONSTRUCTION PERMIT#: Steve Reece

1. WELL USE (Check Applicable Box): Residential Municipal Industrial Agricultural Monitoring
 Recovery Heat Pump Water Injection Other If Other, List Use: _____

2. WELL LOCATION: (Show sketch of the location below)
 Nearest Town: NEWLAND County: AVERY
TURBYFILL RD. OFF HWY 194
(Road Name and Numbers, Community, or Subdivision and Lot No.)

3. DATE DRILLED 6/26/2000
 4. TOTAL DEPTH 300
 5. CUTTINGS COLLECTED YES NO
 6. DOES WELL REPLACE EXISTING WELL? YES NO
 7. STATIC WATER LEVEL Below Top of Casing: 40 FT.
(Use "+" if Above Top of Casing)

8. TOP OF CASING IS 1 FT. Above Land Surface*
*Top of casing terminated at/or below land surface requires a variance in accordance with 15A NCAC 2C.0118
 9. YIELD (gpm): 1.5 METHOD OF TEST Air
 10. WATER ZONES (depth): 1.5 gpm 248-251 0 gpm
0 gpm 0 gpm
 11. CHLORINATION: Type HTH Amount 54

12. CASING:
 Depth Diameter Wall Thickness or Weight/Ft. Material
 From 0 To 61 Ft. 6 1/8 350 PVC
 From _____ To _____ Ft. _____ _____
 From _____ To _____ Ft. _____ _____

13. GROUT:
 Depth Material Method
 From 0 To 20 Ft. Cement Gravity Flow
 From _____ To _____ Ft. _____ _____

14. SCREEN:
 Depth Diameter Slot Size Material
 From _____ To _____ Ft. _____ in. _____ in. _____
 From _____ To _____ Ft. _____ in. _____ in. _____
 From _____ To _____ Ft. _____ in. _____ in. _____


15. SAND/GRAVEL PACK:
 Depth Size Material
 From _____ To _____ Ft. _____ _____
 From _____ To _____ Ft. _____ _____

16. REMARKS:
 I DO HEREBY CERTIFY THAT THIS WELL WAS CONSTRUCTED IN ACCORDANCE WITH 15A NCAC 2C, WELL CONSTRUCTION STANDARDS, AND THAT A COPY OF THIS RECORD HAS BEEN PROVIDED TO THE WELL OWNER.

DRILLING LOG		DEPTH	FORMATION DESCRIPTION
From	To		
0	56		DIRT
56	248		GRANITE
248	251		QUARTZ
251	300		GRANITE

RECEIVED/DEIR
DWD GROUNDWATER SECTION
00 JUL 24 PM 2:09

If additional space is needed use back form

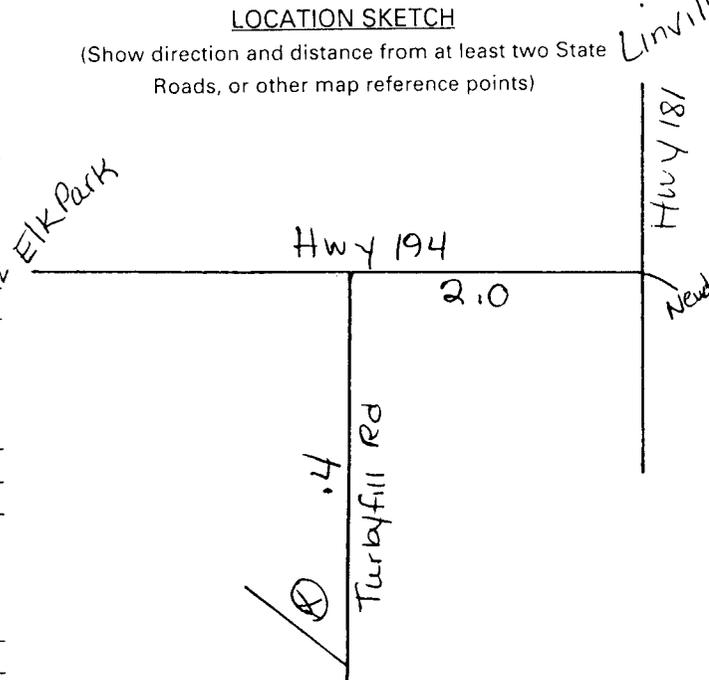

FOR OFFICE USE ONLY
 Quad No: _____
 Serial No: _____

Steve Reece 7-19-00
 SIGNATURE OF PERSON CONSTRUCTING THE WELL DATE
 Submit original to Division of Water Quality, Groundwater Section within 30 days
 GW-1 REV. 12/99