

WELL CONSTRUCTION RECORD

WELL CONTRACTOR: Dewey Wright Well Pump Co., Inc.
 WELL CONTRACTOR CERTIFICATION #: 2688
 STATE WELL CONSTRUCTION PERMIT#: Leslie Reece

99816

1. WELL USE (Check Applicable Box): Residential Municipal Industrial Agricultural Monitoring
 Recovery Heat Pump Water Injection Other If Other, List Use: _____

2. WELL LOCATION: (Show sketch of the location below)
 Nearest Town: BANNER ELK County: AVERY
LOT#10 DEER CRK FALLS OFF BEECH MTN PRKWY OF
(Road Name and Numbers, Community, or Subdivision and Lot No.)

DRILLING LOG		DEPTH
From	To	Formation Description
0	15	DIRT
15	102	GRANITE
102	103	SHALE
103	198	GRANITE
198	199	SHALE
199	425	GRANITE

3. DATE DRILLED 8/9/2000
 4. TOTAL DEPTH 425
 5. CUTTINGS COLLECTED YES NO
 6. DOES WELL REPLACE EXISTING WELL? YES NO
 7. STATIC WATER LEVEL Below Top of Casing: 100 FT.
(Use "+" if Above Top of Casing)

8. TOP OF CASING IS 1 FT. Above Land Surface*
*Top of casing terminated at/or below land surface requires a variance in accordance with 15A NCAC 2C.0118
 9. YIELD (gpm): 2 METHOD OF TEST Air
 10. WATER ZONES (depth) 1/4 gpm 102-103 1.7 gpm 198-199
0 gpm 0 gpm
 11. CHLORINATION: Type HTH Amount 67

12. CASING:

From	To	Depth	Diameter	Wall Thickness or Weight/Ft.	Material
0	21	Ft.	6 1/4	.188	GALV.
From	To	Ft.			
From	To	Ft.			

13. GROUT:

From	To	Depth	Material	Method
0	20	Ft.	Cement	Gravity Flow
From	To	Ft.		


14. SCREEN:

From	To	Depth	Diameter	Slot Size	Material
From	To	Ft.	in.	in.	
From	To	Ft.	in.	in.	
From	To	Ft.	in.	in.	

15. SAND/GRAVEL PACK:

From	To	Depth	Size	Material
From	To	Ft.		
From	To	Ft.		

16. REMARKS: _____
 I DO HEREBY CERTIFY THAT THIS WELL WAS CONSTRUCTED IN ACCORDANCE WITH 15A NCAC 2C, WELL CONSTRUCTION STANDARDS, AND THAT A COPY OF THIS RECORD HAS BEEN PROVIDED TO THE WELL OWNER.

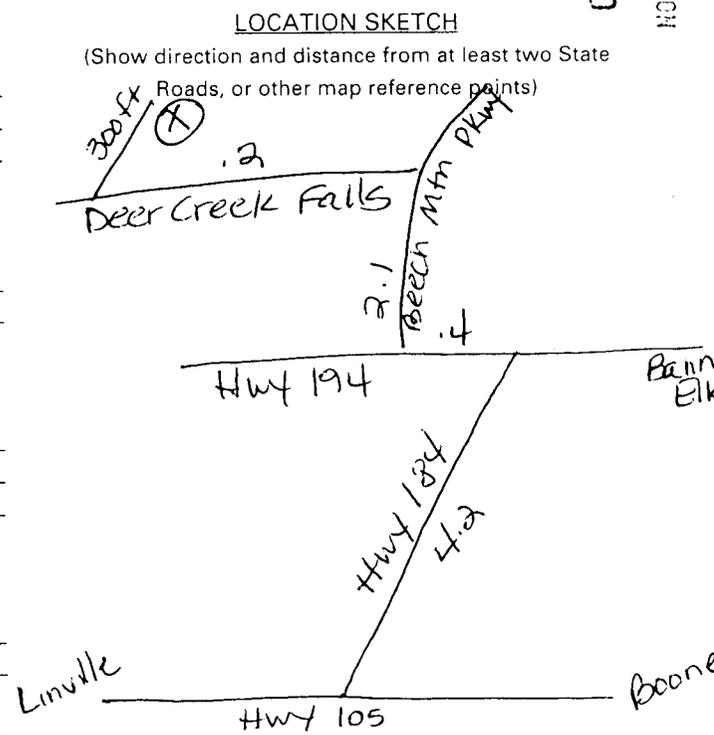

RECEIVED BY: AVERY
 COUNTY ENGINEER/SECTION
 00 AUG 25 PM 1:50

FOR OFFICE USE ONLY

Quad No: _____ Submit original to Division of Water Quality, Groundwater Section within 30 days

Serial No. _____

Leslie Wayne Reece 8-17-00
 SIGNATURE OF PERSON CONSTRUCTING THE WELL DATE