

216132

**WELL CONSTRUCTION RECORD**

WELL CONTRACTOR: Dewey Wright Well Pump Co., Inc.  
 WELL CONTRACTOR CERTIFICATION #: 2888  
 STATE WELL CONSTRUCTION PERMIT#: Leslie Reece

000421

1. WELL USE (Check Applicable Box): Residential  Municipal  Industrial  Agricultural  Monitoring   
 Recovery  Heat Pump Water Injection  Other  If Other, List Use: \_\_\_\_\_

2. WELL LOCATION: (Show sketch of the location below)  
 Nearest Town: NEWLAND County: AVERY  
HORNEY RD. OFF TRIM BRANCH RD. OFF SPANISH OA  
(Road Name and Numbers, Community, or Subdivision and Lot No.)

3.	DRILLING LOG		DEPTH
	From	To	Formation Description
	0	58	DIRT
	58	94	GRANITE
	94	95	SHALE
	95	151	GRANITE
	151	152	SHALE
	152	185	GRANITE


4. DATE DRILLED 7/18/2000  
 5. TOTAL DEPTH 185  
 6. CUTTINGS COLLECTED YES  NO   
 7. DOES WELL REPLACE EXISTING WELL? YES  NO   
 8. STATIC WATER LEVEL Below Top of Casing: 30 FT.  
(Use "+" if Above Top of Casing)  
 9. TOP OF CASING IS 1 FT. Above Land Surface\*  
\*Top of casing terminated at/or below land surface requires a variance in accordance with 15A NCAC 2C.0118  
 10. YIELD (gpm): 3 METHOD OF TEST Air  
 11. WATER ZONES (depth):  
 1 gpm 94-95 2 gpm 151-152  
 0 gpm 0 gpm  
 12. CHLORINATION: Type HTH Amount 34  
If additional space is needed use back of form

RECEIVED / DEPT. ENVIRONMENTAL & NATURAL RESOURCES  
 DIVISION OF GROUNDWATER SECTION  
 00 AUG 25 PM 2:30

13. CASING:

From	To	Depth	Diameter	Wall Thickness or Weight/Ft.	Material
0	63	Ft.	6 1/8	.350	PVC
_____	_____	Ft.	_____	_____	_____
_____	_____	Ft.	_____	_____	_____

LOCATION SKETCH  
 (Show direction and distance from at least two State Roads, or other map reference points)

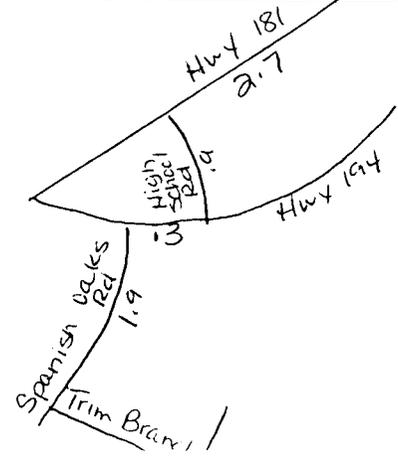

14. GROUT:

From	To	Depth	Material	Method
0	20	Ft.	Cement	Gravity Flow
_____	_____	Ft.	_____	_____

15. SCREEN:

From	To	Depth	Diameter	Slot Size	Material
_____	_____	Ft.	_____ in.	_____ in.	_____
_____	_____	Ft.	_____ in.	_____ in.	_____
_____	_____	Ft.	_____ in.	_____ in.	_____

16. SAND/GRAVEL PACK: