

216608

WELL CONSTRUCTION RECORD

WELL CONTRACTOR: Blasius Wells Drilling
 WELL CONTRACTOR CERTIFICATION #: 2669
 STATE WELL CONSTRUCTION PERMIT#: _____

1. WELL USE (Check Applicable Box): Residential Municipal Industrial Agricultural Monitoring
 Recovery Heat Pump Water Injection Other If Other, List Use: public of G.F.CO.

2. WELL LOCATION: (Show sketch of the location below)
 Nearest Town: Newland County: AVERY

(Road Name and Numbers, Community, or Subdivision and Lot No.)

DRILLING LOG

DEPTH

3. DATE DRILLED 8-9-200
 4. TOTAL DEPTH 960ft
 5. CUTTINGS COLLECTED YES NO
 6. DOES WELL REPLACE EXISTING WELL? YES NO
 7. STATIC WATER LEVEL Below Top of Casing: _____ FT.
 (Use "*" if Above Top of Casing)
 8. TOP OF CASING IS 4 FT. Above Land Surface*

From	To	Formation Description
0	32	reddint brown sand
32	40	shale rock
40	523	granite, white quartz
523	524	cracks 5gal
524	618	granite, white quartz
618	619	cracks 15gal
619	960	granite


9. TOP OF CASING IS 4 FT. Above Land Surface*
 *Top of casing terminated at/or below land surface requires a variance in accordance with 15A NCAC 2C .0418
 10. YIELD (gpm): 20 METHOD OF TEST Air
 11. WATER ZONES (depth): 518 - 523 (15gal)

12. CHLORINATION: Type HTA Amount 30L
 13. CASING:

If additional space is needed use back of form.

LOCATION SKETCH

(Show direction and distance from at least two State Roads, or other map reference points)

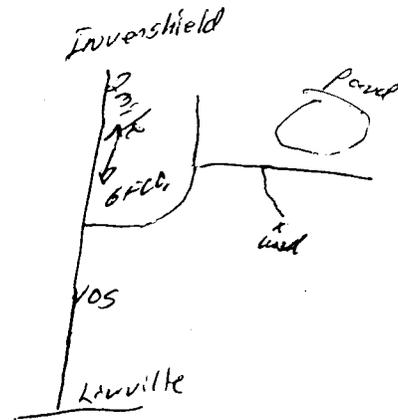

14. GROUT:
 From 0 To 52 Ft. Material concrete Method poured

15. SCREEN:
 From _____ To _____ Ft. _____ in. _____ in. _____
 From _____ To _____ Ft. _____ in. _____ in. _____
 From _____ To _____ Ft. _____ in. _____ in. _____

16. SAND/GRAVEL PACK:
 From _____ To _____ Ft. _____
 From _____ To _____ Ft. _____

17. REMARKS: _____

I DO HEREBY CERTIFY THAT THIS WELL WAS CONSTRUCTED IN ACCORDANCE WITH 15A NCAC 2C, WELL CONSTRUCTION STANDARDS, AND THAT A COPY OF THIS RECORD HAS BEEN PROVIDED TO THE WELL OWNER.

FOR OFFICE USE ONLY

Quad No: _____
 Serial No. _____

Scott J. Jester SIGNATURE OF PERSON CONSTRUCTING THE WELL DATE 8-9-2000
 Submit original to Division of Water Quality, Groundwater Section within 30 days