

217537

WELL CONSTRUCTION RECORD

000505

WELL CONTRACTOR: Dewey Wright Well Pump Co., Inc.
 WELL CONTRACTOR CERTIFICATION #: 2680
 STATE WELL CONSTRUCTION PERMIT#: Leslie Reece

1. WELL USE (Check Applicable Box): Residential Municipal Industrial Agricultural Monitoring
 Recovery Heat Pump Water Injection Other If Other, List Use: _____

2. WELL LOCATION: (Show sketch of the location below)
 Nearest Town: LINNVILLE County: AVERY
CARROLL GRAGG RD. OFF HWY 221
(Road Name and Numbers, Community, or Subdivision and Lot No.)

3. DATE DRILLED 8/31/2000
 4. TOTAL DEPTH 185
 5. CUTTINGS COLLECTED YES NO
 6. DOES WELL REPLACE EXISTING WELL? YES NO
 7. STATIC WATER LEVEL Below Top of Casing: 40 FT.
(Use "+" if Above Top of Casing)

8. TOP OF CASING IS 1 FT. Above Land Surface*
*Top of casing terminated at or below land surface requires a variance in accordance with 15A NCAC 2C.0118

9. YIELD (gpm): 10 METHOD OF TEST Air
 10. WATER ZONES (depth): 2 gpm 83-84 8 gpm 163-164
6 gpm 0 gpm
 11. CHLORINATION: Type HTH Amount 30

DRILLING LOG		DEPTH	FORMATION DESCRIPTION
From	To		
0	23		DIRT
23	58		SANDSTONE
58	83		GRANITE
83	84		SHALE
84	163		GRANITE
163	164		SHALE
164	185		GRANITE

00 SEP 11 AM 9:59

DWD DESIGN/CONSTRUCTION

If additional space is needed use back of form


12. CASING:
 From 0 To 62 Ft. Diameter 6 1/8 Wall Thickness or Weight/Ft. .350 Material PVC
 From _____ To _____ Ft. _____
 From _____ To _____ Ft. _____

13. GROUT:
 From 0 To 20 Ft. Material Cement Method Gravity Flow
 From _____ To _____ Ft. _____

14. SCREEN:
 From _____ To _____ Ft. Diameter _____ Slot Size _____ Material _____
 From _____ To _____ Ft. _____
 From _____ To _____ Ft. _____

15. SAND/GRAVEL PACK:
 From _____ To _____ Ft. Size _____ Material _____
 From _____ To _____ Ft. _____

16. REMARKS: _____
 I DO HEREBY CERTIFY THAT THIS WELL WAS CONSTRUCTED IN ACCORDANCE WITH 15A NCAC 2C, WELL CONSTRUCTION STANDARDS, AND THAT A COPY OF THIS RECORD HAS BEEN PROVIDED TO THE WELL OWNER.

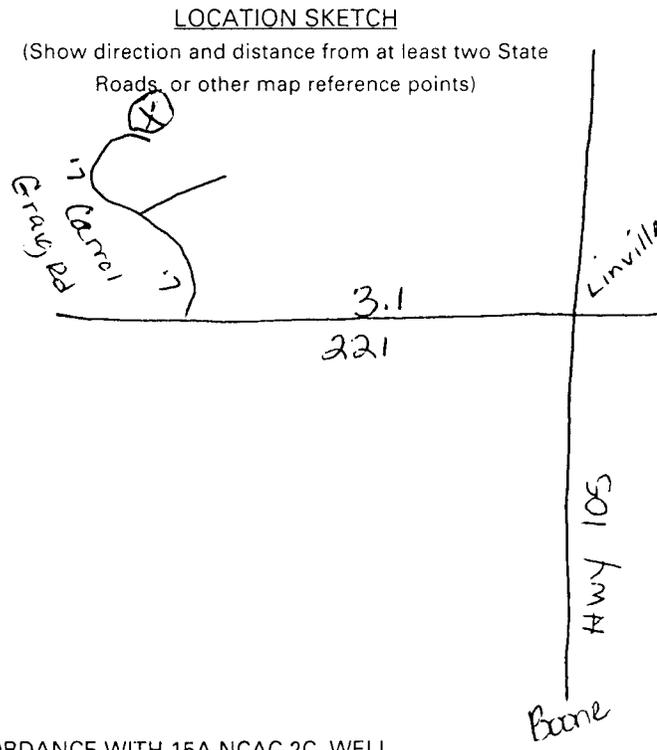

FOR OFFICE USE ONLY

Quad No: _____

Serial No. _____

Leslie Wayne Reece 9-7-00
 SIGNATURE OF PERSON CONSTRUCTING THE WELL DATE
 Submit original to Division of Water Quality, Groundwater Section within 30 days
 GW-1 REV. 12/99