

WELL CONSTRUCTION RECORD

WELL CONTRACTOR: Dewey Wright Well Pump Co., Inc.
 WELL CONTRACTOR CERTIFICATION #: 2888
 STATE WELL CONSTRUCTION PERMIT#: Leslie Reece

000449

1. WELL USE (Check Applicable Box): Residential Municipal Industrial Agricultural Monitoring
 Recovery Heat Pump Water Injection Other If Other, List Use: _____

2. WELL LOCATION: (Show sketch of the location below)
 Nearest Town: BANNER ELK County: EVERY
BEECH MTN RD OFF SAM ELLER RD. OFF HWY 194
(Road Name and Numbers, Community, or Subdivision and Lot No.)

3. _____


 4. DATE DRILLED 8/15/2000
 5. TOTAL DEPTH 325
 6. CUTTINGS COLLECTED YES NO
 7. DOES WELL REPLACE EXISTING WELL? YES NO
 8. STATIC WATER LEVEL Below Top of Casing: 20 FT.
(Use "+" if Above Top of Casing)
 9. TOP OF CASING IS 1 FT. Above Land Surface*
*Top of casing terminated at/or below land surface requires a variance in accordance with 15A NCAC 2C.0118
 10. YIELD (gpm): 5 METHOD OF TEST Air
 11. WATER ZONES (depth): 1/2 gpm 42-43 1/2 gpm 87-89
4 gpm 291-293 0 gpm
 12. CHLORINATION: Type HTH Amount 64

DRILLING LOG		DEPTH
From	To	Formation Description
0	21	DIRT
21	42	GRANITE
42	43	SHALE
43	87	GRANITE
87	88	SHALE
88	291	GRANITE
291	293	SHALE
293	325	GRANITE

If additional space is needed use back of form

13. CASING:

From	To	Depth	Diameter	Wall Thickness or Weight/Ft.	Material
0	25	Ft.	6 1/8	350	PVC
_____	_____	Ft.	_____	_____	_____
_____	_____	Ft.	_____	_____	_____

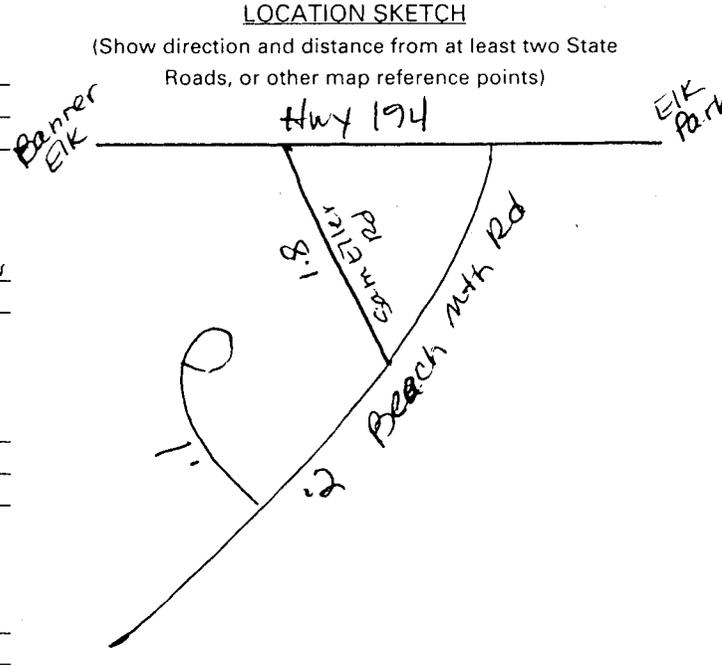

14. GROUT:

From	To	Depth	Material	Method
0	20	Ft.	Cement	Gravity Flow
_____	_____	Ft.	_____	_____

15. SCREEN:

From	To	Depth	Diameter	Slot Size	Material
_____	_____	Ft.	_____ in.	_____ in.	_____
_____	_____	Ft.	_____ in.	_____ in.	_____
_____	_____	Ft.	_____ in.	_____ in.	_____

16. SAND/GRAVEL PACK:

From	To	Depth	Size	Material
_____	_____	Ft.	_____	_____
_____	_____	Ft.	_____	_____

17. REMARKS: _____
 I DO HEREBY CERTIFY THAT THIS WELL WAS CONSTRUCTED IN ACCORDANCE WITH 15A NCAC 2C, WELL CONSTRUCTION STANDARDS, AND THAT A COPY OF THIS RECORD HAS BEEN PROVIDED TO THE WELL OWNER.

FOR OFFICE USE ONLY

Quad No: _____

Serial No. _____

Leslie Wayne Reece 9-2-00
 SIGNATURE OF PERSON CONSTRUCTING THE WELL DATE
 Submit original to Division of Water Quality, Groundwater Section within 30 days
 GW-1 REV. 12/99