

218039

WELL CONSTRUCTION RECORD

WELL CONTRACTOR: Dunnell Well Drilling
WELL CONTRACTOR CERTIFICATION #: 2133
STATE WELL CONSTRUCTION PERMIT#: 2669

1. WELL USE (Check Applicable Box): Residential Municipal Industrial Agricultural Monitoring
Recovery Heat Pump Water Injection Other If Other, List Use: _____

2. WELL LOCATION: (Show sketch of the location below)
Nearest Town: Elk Park County: Avery Co
7416 Elk Cr Rd
(Road Name and Numbers, Community, or Subdivision and Lot No.)


3. City or Town _____ State _____ Zip Code _____
4. DATE DRILLED 9-18-2008
5. TOTAL DEPTH 300
6. CUTTINGS COLLECTED YES NO
7. DOES WELL REPLACE EXISTING WELL? YES NO
8. STATIC WATER LEVEL Below Top of Casing: 60 FT.
(Use "*" if Above Top of Casing)
9. TOP OF CASING IS 9 FT. Above Land Surface*
*Top of casing terminated at/or below land surface requires a variance in accordance with 15A NCAC 2C .0118.
10. YIELD (gpm): 5 METHOD OF TEST Air
11. WATER ZONES (depth): 110-112
12. CHLORINATION: Type HTH Amount 302
13. CASING:

DRILLING LOG		DEPTH
From	To	Formation Description
0	17	brackish water
17	110	granite
110	112	shale rock
112	300	granite

If additional space is needed use back of form

LOCATION SKETCH

(Show direction and distance from at least two State Roads, or other map reference points)

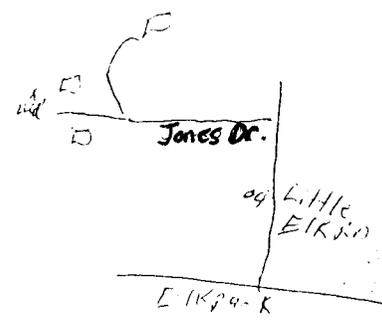

From	Depth	To	Diameter	Wall Thickness or Weight/Ft.	Material
0	1	20	6 1/2"	183	Galv

14. GROUT:

From	Depth	To	Material	Method
0		20	concrete	poured

15. SCREEN:

From	Depth	To	Diameter	Slot Size	Material

16. SAND/GRAVEL PACK:

From	Depth	To	Size	Material

17. REMARKS:

I DO HEREBY CERTIFY THAT THIS WELL WAS CONSTRUCTED IN ACCORDANCE WITH 15A NCAC 2C, WELL CONSTRUCTION STANDARDS, AND THAT A COPY OF THIS RECORD HAS BEEN PROVIDED TO THE WELL OWNER.

FOR OFFICE USE ONLY
Quad No: _____
Serial No: _____

SIGNATURE OF PERSON CONSTRUCTING THE WELL: [Signature] DATE: 9-18-2008
Submit original to Division of Water Quality, Groundwater Section within 30 days