

219802

WELL CONSTRUCTION RECORD

WELL CONTRACTOR: 2669 Dismore Well Drilling
 WELL CONTRACTOR CERTIFICATION #: 2133
 STATE WELL CONSTRUCTION PERMIT#: 2669

1. WELL USE (Check Applicable Box): Residential Municipal Industrial Agricultural Monitoring
 Recovery Heat Pump Water Injection Other If Other, List Use: private

2. WELL LOCATION: (Show sketch of the location below)
 Nearest Town: Newland County: Ashe
Apple Tree Ridge, Newland, N.C.
 (Road Name and Numbers, Community, or Subdivision and Lot No.)

3. DATE DRILLED 10-17-00
 4. TOTAL DEPTH 730
 5. CUTTINGS COLLECTED YES NO
 6. DOES WELL REPLACE EXISTING WELL? YES NO
 7. STATIC WATER LEVEL Below Top of Casing: 300 FT.
 (Use "*" if Above Top of Casing)
 8. TOP OF CASING IS 1 FT. Above Land Surface*
 *Top of casing terminated at or below land surface requires a variance in accordance with 15A NCAC 2C .0118
 9. YIELD (gpm): 11 METHOD OF TEST Air
 10. WATER ZONES (depth): 690 gal
 11. CHLORINATION: Type HTH Amount 20
 12. CASING:

DRILLING LOG		DEPTH
From	To	Formation Description
0	32	black red dirt
32	660	staleck granite
660	661	white quartzite
661	730	granite & bituminous

RECEIVED

Groundwater Section
Asheville Regional Office


From	Depth	To	Diameter	Wall Thickness or Weight/Ft.	Material
0	0	44	6.4	SPR21	PVC

From	Depth	To	Material	Method
0	0	20	Cement	grout

From	Depth	To	Diameter	Slot Size	Material

From	Depth	To	Size	Material

17. REMARKS:

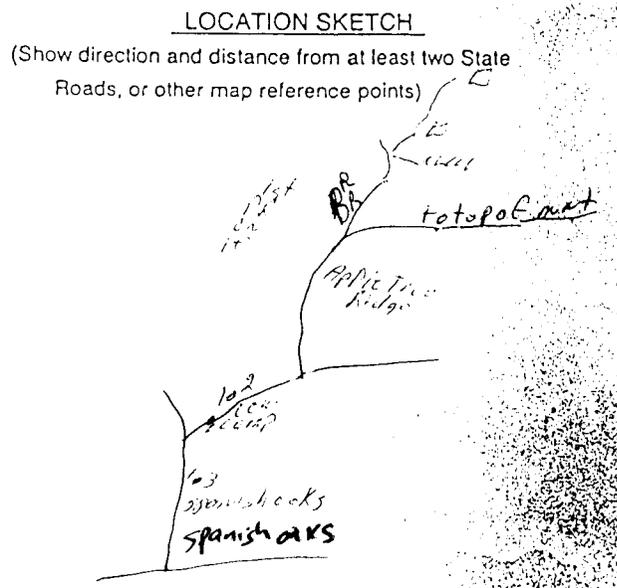

I DO HEREBY CERTIFY THAT THIS WELL WAS CONSTRUCTED IN ACCORDANCE WITH 15A NCAC 2C, WELL CONSTRUCTION STANDARDS, AND THAT A COPY OF THIS RECORD HAS BEEN PROVIDED TO THE WELL OWNER.

FOR OFFICE USE ONLY
 Quad No: _____
 Serial No: _____

John J. [Signature] 10-17-2000
 SIGNATURE OF PERSON CONSTRUCTING THE WELL DATE
 Submit original to Division of Water Quality, Groundwater Section within 30 days