

119808

WELL CONSTRUCTION RECORD

WELL CONTRACTOR: Bassett Well Drilling  
WELL CONTRACTOR CERTIFICATION #: 2133  
STATE WELL CONSTRUCTION PERMIT#: \_\_\_\_\_

1. WELL USE (Check Applicable Box): Residential  Municipal  Industrial  Agricultural  Monitoring   
Recovery  Heat Pump Water Injection  Other  If Other, List Use: \_\_\_\_\_


2. WELL LOCATION: (Show sketch of the location below)  
Nearest Town: EIK Park County: Alerty

(Road Name and Numbers, Community, or Subdivision and Lot No.)

3. \_\_\_\_\_  
City or Town \_\_\_\_\_ State \_\_\_\_\_ Zip Code \_\_\_\_\_  
4. DATE DRILLED 10-6-00  
5. TOTAL DEPTH 200  
6. CUTTINGS COLLECTED YES  NO   
7. DOES WELL REPLACE EXISTING WELL? YES  NO   
8. STATIC WATER LEVEL Below Top of Casing: 50 FT.  
(Use "\*" if Above Top of Casing)  
9. TOP OF CASING IS 1 FT. Above Land Surface\*

DRILLING LOG		DEPTH
From	To	Formation Description
0	17	red dirt
17	80	Drainsand
80	104	shale rock slate
104	152	shale rock granite
152	157	brown slate gal
157	200	granite

Top of casing terminated at/ or below land surface requires a variance in accordance with 15A NCAC 2C .0118  
10. YIELD (gpm): 25 METHOD OF TEST Air  
11. WATER ZONES (depth): 152-157  
12. CHLORINATION: Type HTH Amount 300  
13. CASING:

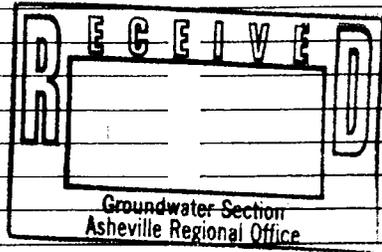

If additional space is needed use back of form

LOCATION SKETCH  
(Show direction and distance from at least two State Roads, or other map reference points)

From	Depth	To	Diameter	Wall Thickness or Weight/Ft.	Material
-1		104	6.5	138	Galv
_____	_____	_____	_____	_____	_____
_____	_____	_____	_____	_____	_____

14. GROUT:

From	Depth	To	Material	Method
0		20	Cement	pour in
_____	_____	_____	_____	_____


15. SCREEN:

From	Depth	To	Diameter	Slot Size	Material
_____	_____	_____	_____ in.	_____ in.	_____
_____	_____	_____	_____ in.	_____ in.	_____
_____	_____	_____	_____ in.	_____ in.	_____

16. SAND/GRAVEL PACK:

From	Depth	To	Size	Material
_____	_____	_____	_____	_____
_____	_____	_____	_____	_____

17. REMARKS: \_\_\_\_\_

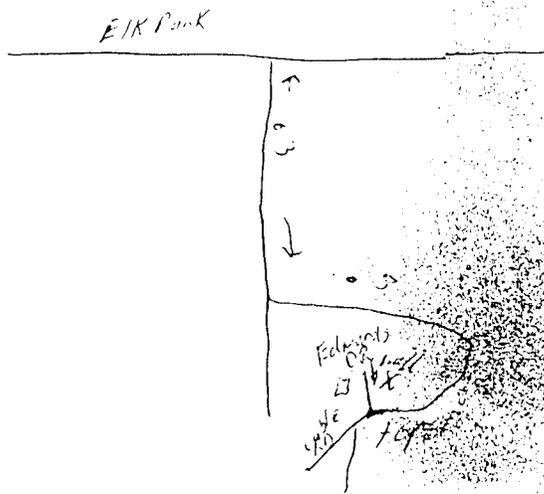

I DO HEREBY CERTIFY THAT THIS WELL WAS CONSTRUCTED IN ACCORDANCE WITH 15A NCAC 2C, WELL CONSTRUCTION STANDARDS, AND THAT A COPY OF THIS RECORD HAS BEEN PROVIDED TO THE WELL OWNER.

FOR OFFICE USE ONLY  
Quad No: \_\_\_\_\_  
Serial No. \_\_\_\_\_

SIGNATURE OF PERSON CONSTRUCTING THE WELL: [Signature] DATE: 10-6-2000  
Submit original to Division of Water Quality, Groundwater Section within 30 days  
GW-1 REV. 12/99