

**WELL CONSTRUCTION RECORD**

000653

WELL CONTRACTOR: Dewey Wright Well Pump Co., Inc.  
 WELL CONTRACTOR CERTIFICATION #: 2681  
 STATE WELL CONSTRUCTION PERMIT#: Steve Petty

1. WELL USE (Check Applicable Box): Residential  Municipal  Industrial  Agricultural  Monitoring   
 Recovery  Heat Pump Water Injection  Other  If Other, List Use: \_\_\_\_\_

2. WELL LOCATION: (Show sketch of the location below)  
 Nearest Town: BOONE County: AVERY  
FLAT SPRINGS RD. OFF HWY 321  
(Road Name and Numbers, Community, or Subdivision and Lot No.)


3. DATE DRILLED 10/9/2000  
 4. TOTAL DEPTH 145  
 5. CUTTINGS COLLECTED YES  NO   
 6. DOES WELL REPLACE EXISTING WELL? YES  NO   
 7. STATIC WATER LEVEL Below Top of Casing: 10 FT.  
(Use "+" if Above Top of Casing)

DRILLING LOG		DEPTH
From	To	Formation Description
0	45	DIRT
45	125	GRANITE
125	128	SHALE
128	145	GRANITE
If additional space is needed use back of form		

9. TOP OF CASING IS 1 FT. Above Land Surface\*  
\*Top of casing terminated at/or below land surface requires a variance in accordance with 15A NCAC 2C.0118  
 10. YIELD (gpm): 6 METHOD OF TEST Air  
 11. WATER ZONES (depth): 0 gpm 125-128 0 gpm  
0 gpm 0 gpm  
 12. CHLORINATION: Type HTH Amount 20

13. CASING:  
 Depth Diameter Wall Thickness or Weight/Ft. Material  
 From 0 To 50 Ft. 6 1/8 .350 PVC  
 From \_\_\_\_\_ To \_\_\_\_\_ Ft. \_\_\_\_\_ \_\_\_\_\_  
 From \_\_\_\_\_ To \_\_\_\_\_ Ft. \_\_\_\_\_ \_\_\_\_\_

**LOCATION SKETCH**  
 (Show direction and distance from at least two State Roads, or other map reference points)

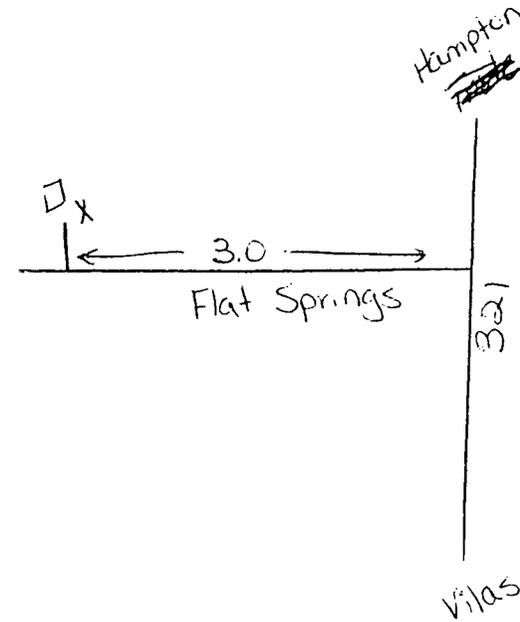

14. GROUT:  
 Depth Material Method  
 From 0 To 20 Ft. Cement Gravity Flow  
 From \_\_\_\_\_ To \_\_\_\_\_ Ft. \_\_\_\_\_ \_\_\_\_\_

15. SCREEN:  
 Depth Diameter Slot Size Material  
 From \_\_\_\_\_ To \_\_\_\_\_ Ft. \_\_\_\_\_ in. \_\_\_\_\_ in. \_\_\_\_\_  
 From \_\_\_\_\_ To \_\_\_\_\_ Ft. \_\_\_\_\_ in. \_\_\_\_\_ in. \_\_\_\_\_  
 From \_\_\_\_\_ To \_\_\_\_\_ Ft. \_\_\_\_\_ in. \_\_\_\_\_ in. \_\_\_\_\_

16. SAND/GRAVEL PACK:  
 Depth Size Material  
 From \_\_\_\_\_ To \_\_\_\_\_ Ft. \_\_\_\_\_ \_\_\_\_\_  
 From \_\_\_\_\_ To \_\_\_\_\_ Ft. \_\_\_\_\_ \_\_\_\_\_

17. REMARKS: \_\_\_\_\_  
 I DO HEREBY CERTIFY THAT THIS WELL WAS CONSTRUCTED IN ACCORDANCE WITH 15A NCAC 2C, WELL CONSTRUCTION STANDARDS, AND THAT A COPY OF THIS RECORD HAS BEEN PROVIDED TO THE WELL OWNER.

**FOR OFFICE USE ONLY**  
 Groundwater Section  
 Asheville Regional Office

Steve Petty  
 SIGNATURE OF PERSON CONSTRUCTING THE WELL  
 DATE 11-16-00  
 Submit original to Division of Water Quality, Groundwater Section within 30 days