

WELL CONSTRUCTION RECORD

WELL CONTRACTOR: Dewey Wright Well Pump Co., Inc.
 WELL CONTRACTOR CERTIFICATION #: 2888
 STATE WELL CONSTRUCTION PERMIT#: Leslie Reece

000698

1. WELL USE (Check Applicable Box): Residential Municipal Industrial Agricultural Monitoring
 Recovery Heat Pump Water Injection Other If Other, List Use: _____

2. WELL LOCATION: (Show sketch of the location below)
 Nearest Town: BANNER ELK County: AVERY
GARY GWYN RD OFF ELK RIVER RD #1305
(Road Name and Numbers, Community, or Subdivision and Lot No.)

| DRILLING LOG | | DEPTH |
|--------------|-----|-----------------------|
| From | To | Formation Description |
| 0 | 20 | DIRT |
| 20 | 103 | GRANITE |
| 103 | 104 | SHALE |
| 104 | 261 | GRANITE |
| 261 | 262 | SHALE |
| 262 | 285 | GRANITE |

3. _____
 4. DATE DRILLED 11/14/2000
 5. TOTAL DEPTH 285
 6. CUTTINGS COLLECTED YES NO
 7. DOES WELL REPLACE EXISTING WELL? YES NO
 8. STATIC WATER LEVEL Below Top of Casing: 100 FT.
(Use "+" if Above Top of Casing)

9. TOP OF CASING IS 1 FT. Above Land Surface*
*Top of casing terminated at/or below land surface requires a variance in accordance with 15A NCAC 2C.0118
 10. YIELD (gpm): 30 METHOD OF TEST Air
 11. WATER ZONES (depth): 1/2 gpm 103-104 29.5 gpm 261-262
0 gpm 0 gpm
 12. CHLORINATION: Type HTH Amount 39

13. CASING:

| From | To | Depth | Diameter | Wall Thickness or Weight/Ft. | Material |
|-------|-------|-------|----------|------------------------------|----------|
| 0 | 23 | Ft. | 6 1/8 | .350 | PVC |
| _____ | _____ | Ft. | _____ | _____ | _____ |
| _____ | _____ | Ft. | _____ | _____ | _____ |

14. GROUT:

| From | To | Depth | Material | Method |
|-------|-------|-------|----------|--------------|
| 0 | 20 | Ft. | Cement | Gravity Flow |
| _____ | _____ | Ft. | _____ | _____ |


15. SCREEN:

| From | To | Depth | Diameter | Slot Size | Material |
|-------|-------|-------|-----------|-----------|----------|
| _____ | _____ | Ft. | _____ in. | _____ in. | _____ |
| _____ | _____ | Ft. | _____ in. | _____ in. | _____ |
| _____ | _____ | Ft. | _____ in. | _____ in. | _____ |

16. SAND/GRAVEL PACK:

| From | To | Depth | Size | Material |
|-------|-------|-------|-------|----------|
| _____ | _____ | Ft. | _____ | _____ |
| _____ | _____ | Ft. | _____ | _____ |

17. REMARKS:
 I DO HEREBY CERTIFY THAT THIS WELL WAS CONSTRUCTED IN ACCORDANCE WITH 15A NCAC 2C, WELL CONSTRUCTION STANDARDS, AND THAT A COPY OF THIS RECORD HAS BEEN PROVIDED TO THE WELL OWNER.

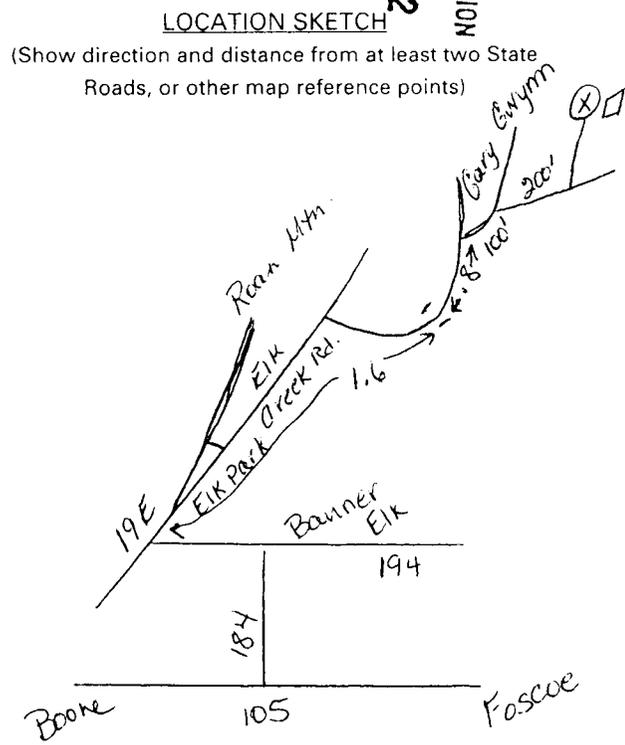

RECEIVED / DEPT
 DWD GROUNDWATER SECTION
 00 DEC 20 AM 10:42

FOR OFFICE USE ONLY
 Quad No: _____
 Serial No: _____

Leslie Wayne Reece 12-7-00
 SIGNATURE OF PERSON CONSTRUCTING THE WELL DATE