

**WELL CONSTRUCTION RECORD**

000823

WELL CONTRACTOR: Dewey Wright Well Pump Co., Inc.  
 WELL CONTRACTOR CERTIFICATION #: 2881  
 STATE WELL CONSTRUCTION PERMIT#: Steve Petty

1. WELL USE (Check Applicable Box): Residential  Municipal  Industrial  Agricultural  Monitoring   
 Recovery  Heat Pump Water Injection  Other  If Other, List Use: \_\_\_\_\_

2. WELL LOCATION: (Show sketch of the location below)

Nearest Town: LINNVILLE County: AVERY  
JACKSON LN OFF LICKLOG RD. OFF SQUIRREL CRK R  
(Road Name and Numbers, Community, or Subdivision and Lot No.)

3. \_\_\_\_\_  
 \_\_\_\_\_  
 \_\_\_\_\_

4. DATE DRILLED 12/28/2000

5. TOTAL DEPTH 305

6. CUTTINGS COLLECTED YES  NO

7. DOES WELL REPLACE EXISTING WELL? YES  NO

8. STATIC WATER LEVEL Below Top of Casing: 20 FT.  
(Use "+" if Above Top of Casing)

9. TOP OF CASING IS 1 FT. Above Land Surface\*  
\*Top of casing terminated at or below land surface requires a variance in accordance with 15A NCAC 2C.0118

10. YIELD (gpm): 5 METHOD OF TEST Air

11. WATER ZONES (depth): 5 gpm 270-272 0 gpm  
0 gpm 0 gpm

12. CHLORINATION: Type HTH Amount 58

DRILLING LOG		DEPTH
From	To	Formation Description
0	140	DIRT
140	270	GRANITE
270	272	SHALE
272	305	GRANITE


RECEIVED BY DIVISION  
 DIVISION OF GROUNDWATER SURVEILLATION  
 01 FEB - 5 PM 1:57

13. CASING:

Depth	Diameter	Wall Thickness or Weight/Ft.	Material
From <u>0</u> To <u>145</u> Ft.	<u>6 1/4</u>	<u>.188</u>	<u>GALV.</u>
From _____ To _____ Ft.	_____	_____	_____
From _____ To _____ Ft.	_____	_____	_____

**LOCATION SKETCH**

(Show direction and distance from at least two State Roads, or other map reference points)

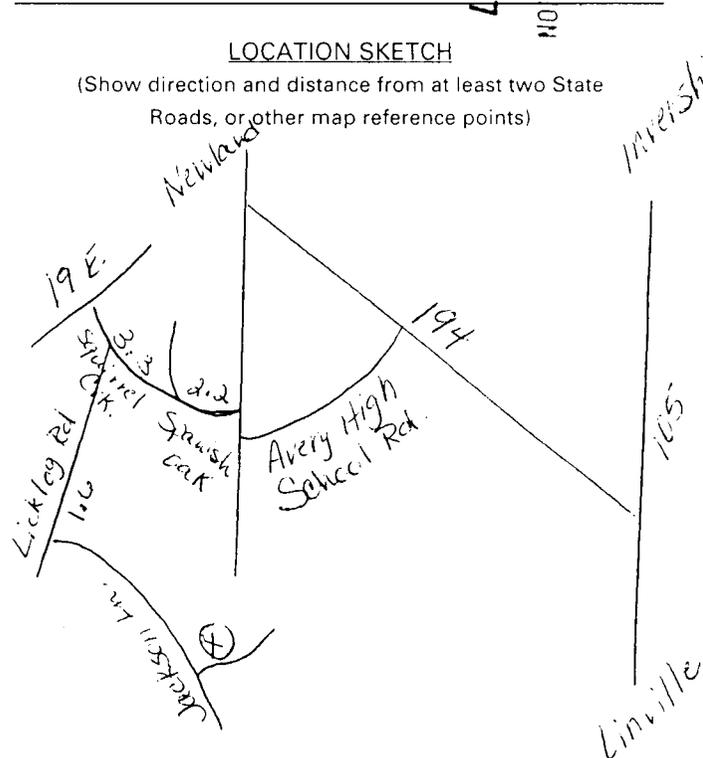

14. GROUT:

Depth	Material	Method
From <u>0</u> To <u>20</u> Ft.	<u>Cement</u>	<u>Gravity Flow</u>
From _____ To _____ Ft.	_____	_____

15. SCREEN:

Depth	Diameter	Slot Size	Material
From _____ To _____ Ft.	_____ in.	_____ in.	_____
From _____ To _____ Ft.	_____ in.	_____ in.	_____
From _____ To _____ Ft.	_____ in.	_____ in.	_____

16. SAND/GRAVEL PACK:

Depth	Size	Material
From _____ To _____ Ft.	_____	_____
From _____ To _____ Ft.	_____	_____

17. REMARKS: \_\_\_\_\_

I DO HEREBY CERTIFY THAT THIS WELL WAS CONSTRUCTED IN ACCORDANCE WITH 15A NCAC 2C, WELL CONSTRUCTION STANDARDS, AND THAT A COPY OF THIS RECORD HAS BEEN PROVIDED TO THE WELL OWNER.

**FOR OFFICE USE ONLY**

Quad No: \_\_\_\_\_

Serial No. \_\_\_\_\_

*Steve Petty*

SIGNATURE OF PERSON CONSTRUCTING THE WELL  
 Submit original to Division of Water Quality, Groundwater Section within 30 days

1-31-01

DATE