

226522

Beaswell Well Drilling

WELL CONSTRUCTION RECORD

WELL CONTRACTOR: Beaswell Well Drilling
WELL CONTRACTOR CERTIFICATION #: 2669
STATE WELL CONSTRUCTION PERMIT#: 2669

1. WELL USE (Check Applicable Box): Residential Municipal Industrial Agricultural Monitoring
Recovery Heat Pump Water Injection Other If Other, List Use: private

2. WELL LOCATION: (Show sketch of the location below)
Nearest Town: Newland County: Avery

(Road Name and Numbers, Community, or Subdivision and Lot No.)

3. DATE DRILLED 10-18-00
4. TOTAL DEPTH 800
5. CUTTINGS COLLECTED YES NO
6. DOES WELL REPLACE EXISTING WELL? YES NO
7. STATIC WATER LEVEL Below Top of Casing: 1 FT.
(Use "+" If Above Top of Casing)
8. TOP OF CASING IS 2 FT. Above Land Surface*

DRILLING LOG

From	To	DEPTH	Formation Description
0	72		red brown dirt shales
72	110		granite
110	112		shales
112	800		granite, white quartz

DATE: FEB 19 PM 3:00
TIME: 3:00
SECTION:

*Top of casing terminated at/or below land surface requires a variance in accordance with 15A NCAC 2C .0118.
10. YIELD (gpm): 1 pint METHOD OF TEST Air
11. WATER ZONES (depth): 110-112
12. CHLORINATION: Type HTH Amount 362
13. CASING:

From	To	Depth	Diameter	Wall Thickness or Weigh/Ft.	Material
-1	72	Ft.	6 1/4	SDR 21	PVC
From	To	Ft.			
From	To	Ft.			

14. GROUT:

From	To	Depth	Material	Method
0	26	Ft.	common	poored
From	To	Ft.		

15. SCREEN:


From	To	Depth	Diameter	Slot Size	Material
From	To	Ft.	in.	in.	
From	To	Ft.	in.	in.	
From	To	Ft.	in.	in.	

16. SAND/GRAVEL PACK:

From	To	Depth	Size	Material
From	To	Ft.		
From	To	Ft.		

17. REMARKS:

LOCATION SKETCH
(Show direction and distance from at least two State Roads, or other map reference points)

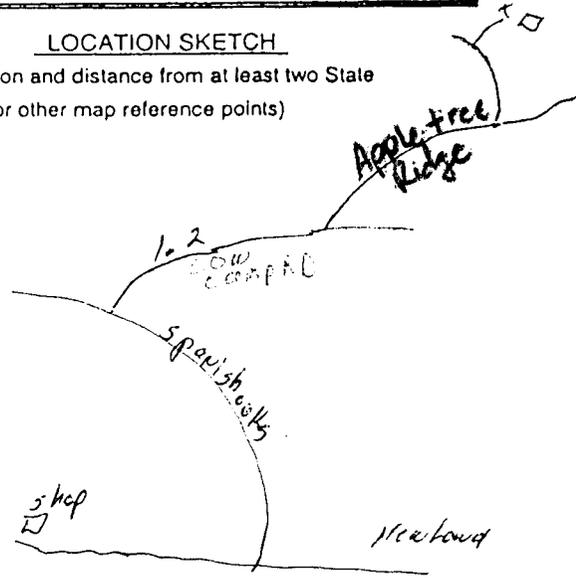

I DO HEREBY CERTIFY THAT THIS WELL WAS CONSTRUCTED IN ACCORDANCE WITH 15A NCAC 2C, WELL CONSTRUCTION STANDARDS, AND THAT A COPY OF THIS RECORD HAS BEEN PROVIDED TO THE WELL OWNER.

FOR OFFICE USE ONLY
Quad No: _____
Serial No. _____

Kimberly G. Taylor
SIGNATURE OF PERSON CONSTRUCTING THE WELL
DATE: 10-13-2000

Submit original to Division of Water Quality, Groundwater Section within 30 days