

WELL CONSTRUCTION RECORD

WELL CONTRACTOR: BRASWELL Well Drilling
 WELL CONTRACTOR CERTIFICATION #: 2133, 2669
 STATE WELL CONSTRUCTION PERMIT#: _____

1. WELL USE (Check Applicable Box): Residential Municipal Industrial Agricultural Monitoring
 Recovery Heat Pump Water Injection Other If Other, List Use: private

2. WELL LOCATION: (Show sketch of the location below)
 Nearest Town: Newland County: Avery

(Road Name and Numbers, Community, or Subdivision and Lot No.)

3. _____
 4. DATE DRILLED 12-26-00
 5. TOTAL DEPTH 180
 6. CUTTINGS COLLECTED YES NO
 7. DOES WELL REPLACE EXISTING WELL? YES NO
 8. STATIC WATER LEVEL Below Top of Casing: 20 FT.
 (Use "*" if Above Top of Casing)
 9. TOP OF CASING IS 4 FT. Above Land Surface*

DRILLING LOG		DEPTH
From	To	Formation Description
0	65	brn sand/clay
65	100	granite
100	102	concrete
102	147	granite
147	151	plint white sands
151	180	granite

*Top of casing terminated at/ or below land surface requires a variance in accordance with 15A NCAC 2C .0118


10. YIELD (gpm): 15 METHOD OF TEST Air
 11. WATER ZONES (depth): 100-102 29 gal
147-151-139 gal

12. CHLORINATION: Type _____ Amount _____
 13. CASING: _____

If additional space is needed use back of form

LOCATION SKETCH

(Show direction and distance from at least two State Roads, or other map reference points)

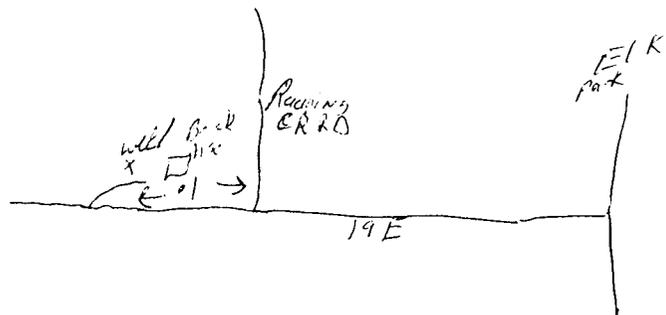

From	Depth	To	Diameter	Wall Thickness	Material
				or Weight/Ft.	
From <u>1</u>	Depth <u>64</u>	To	Diameter <u>6-3/4</u>	Wall Thickness <u>180</u>	Material <u>Galv</u>
From _____	To _____	Ft. _____	Ft. _____	_____	_____
From _____	To _____	Ft. _____	_____	_____	_____

From	Depth	To	Material	Method
From <u>0</u>	Depth <u>20</u>	To	Material <u>concrete</u>	Method <u>poured</u>
From _____	To _____	Ft. _____	_____	_____

From	Depth	To	Diameter	Slot Size	Material
From _____	To _____	Ft. _____	in. _____	in. _____	_____
From _____	To _____	Ft. _____	in. _____	in. _____	_____
From _____	To _____	Ft. _____	in. _____	in. _____	_____

From	Depth	To	Size	Material
From _____	To _____	Ft. _____	_____	_____
From _____	To _____	Ft. _____	_____	_____

17. REMARKS: old school Teacher

I DO HEREBY CERTIFY THAT THIS WELL WAS CONSTRUCTED IN ACCORDANCE WITH 15A NCAC 2C, WELL CONSTRUCTION STANDARDS, AND THAT A COPY OF THIS RECORD HAS BEEN PROVIDED TO THE WELL OWNER.

FOR OFFICE USE ONLY
 Quad No: _____
 Serial No. _____

SIGNATURE OF PERSON CONSTRUCTING THE WELL: [Signature] DATE: 12-26-2000
 Submit original to Division of Water Quality, Groundwater Section within 30 days