

25107

# WELL CONSTRUCTION RECORD

WELL CONTRACTOR: Dewey Wright Well Pump Co., Inc.  
 WELL CONTRACTOR CERTIFICATION #: 2878  
 STATE WELL CONSTRUCTION PERMIT#: Steve Price

000855

1. WELL USE (Check Applicable Box): Residential  Municipal  Industrial  Agricultural  Monitoring   
 Recovery  Heat Pump Water Injection  Other  If Other, List Use: \_\_\_\_\_

2. WELL LOCATION: (Show sketch of the location below)  
 Nearest Town: MINNEAPOLIS County: AVERY  
PRIVATE DR OFF HWY 19E  
(Road Name and Numbers, Community, or Subdivision and Lot No.)

3. \_\_\_\_\_  
 4. DATE DRILLED 1/1/2001  
 5. TOTAL DEPTH 205  
 6. CUTTINGS COLLECTED YES  NO   
 7. DOES WELL REPLACE EXISTING WELL? YES  NO   
 8. STATIC WATER LEVEL Below Top of Casing: 10 FT.  
(Use "+" if Above Top of Casing)


DRILLING LOG		DEPTH	FORMATION DESCRIPTION
From	To	Formation Description	
0	60	DIRT	RECEIVED/ENTERED DWG GROUNDWATER SECTION 01 FEB - 5 PM : 56
60	120	GRANITE	
120	123	QUARTZ	
123	205	GRANITE	
If additional space is needed use back of form			

9. TOP OF CASING IS 1 FT. Above Land Surface\*  
\*Top of casing terminated at/or below land surface requires a variance in accordance with 15A NCAC 2C.0118  
 10. YIELD (gpm): 15 METHOD OF TEST Air  
 11. WATER ZONES (depth): 2 gpm 60-120 3 gpm 120-123  
10 gpm 123-205 0 gpm  
 12. CHLORINATION: Type HTH Amount 42

13. CASING:

Depth	Diameter	Wall Thickness or Weight/Ft.	Material
From <u>0</u> To <u>63</u> Ft.	<u>6 1/4</u>	<u>188</u>	<u>GALV</u>
From _____ To _____ Ft.	_____	_____	_____
From _____ To _____ Ft.	_____	_____	_____

LOCATION SKETCH  
 (Show direction and distance from at least two State Roads, or other map reference points)

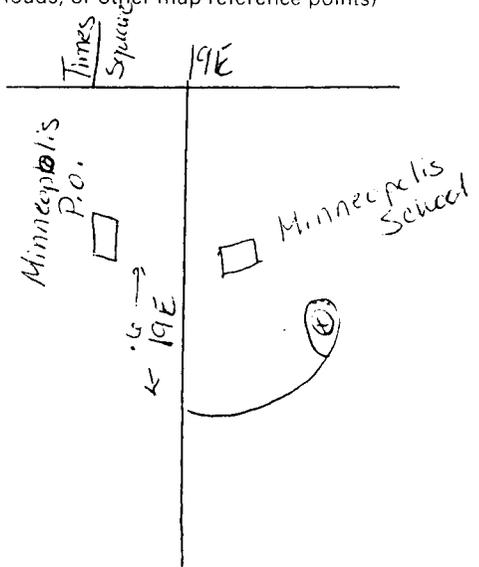

14. GROUT:

Depth	Material	Method
From <u>0</u> To <u>20</u> Ft.	<u>Cement</u>	<u>Gravity Flow</u>
From _____ To _____ Ft.	_____	_____

15. SCREEN:

Depth	Diameter	Slot Size	Material
From _____ To _____ Ft.	_____ in.	_____ in.	_____
From _____ To _____ Ft.	_____ in.	_____ in.	_____
From _____ To _____ Ft.	_____ in.	_____ in.	_____

16. SAND/GRAVEL PACK:

Depth	Size	Material
From _____ To _____ Ft.	_____	_____
From _____ To _____ Ft.	_____	_____

17. REMARKS: \_\_\_\_\_  
 I DO HEREBY CERTIFY THAT THIS WELL WAS CONSTRUCTED IN ACCORDANCE WITH 15A NCAC 2C, WELL CONSTRUCTION STANDARDS, AND THAT A COPY OF THIS RECORD HAS BEEN PROVIDED TO THE WELL OWNER.

FOR OFFICE USE ONLY

Quad No: \_\_\_\_\_

Serial No. \_\_\_\_\_

Groundwater Section  
 Asheville Regional Office

Steve Price SIGNATURE OF PERSON CONSTRUCTING THE WELL DATE 2-1-01

Submit original to Division of Water Quality, Groundwater Section within 30 days